
#3922

PLAT OF SURVEY OF

LOT 3, LAKE GENEVA HIGHLANDS, LOCATED IN SECTION 8, T1N, R17E, WALWORTH COUNTY, WISCONSIN.

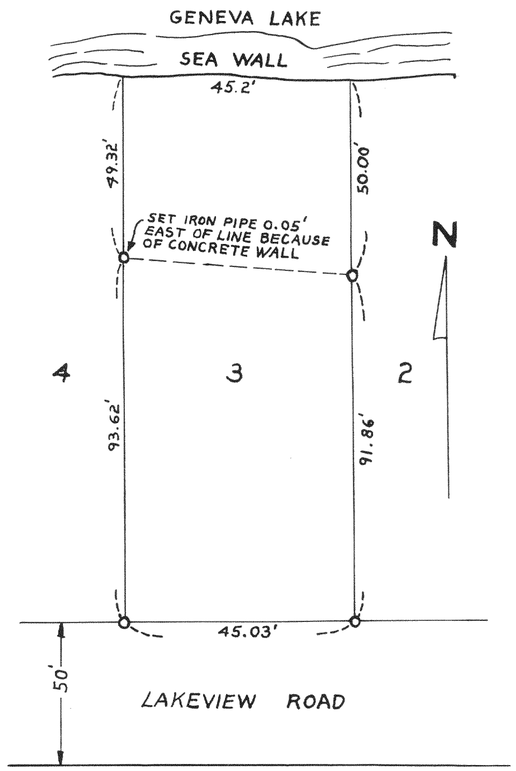


APRIL 21, 1960 — Floyd L. Jensen — COUNTY SURVEYOR

#3923

PLAT OF SURVEY OF

THE SOUTH 105 FEET OF LOT 3, BLOCK 10, ORIGINAL PLAT OF THE VILLAGE OF EAST TROY, WALWORTH COUNTY, WISCONSIN.

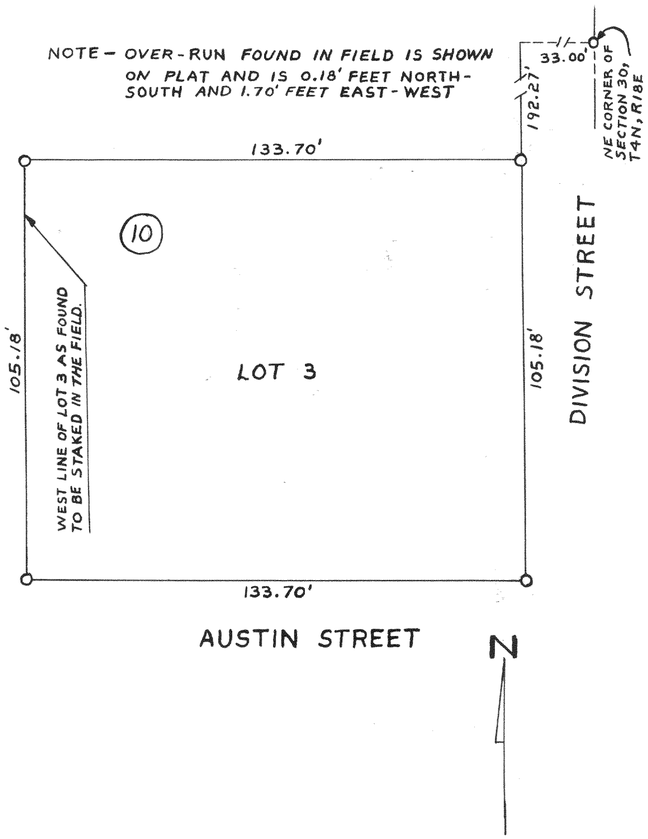


FEBRUARY, 1960 — Floyd L. Jensen — COUNTY SURVEYOR

#3924

PLAT OF SURVEY OF

LOTS 9097 TO 9102, BLOCK 163, LAKE COMO BEACH, LOCATED IN T2N, R17E, WALWORTH COUNTY, WISCONSIN.

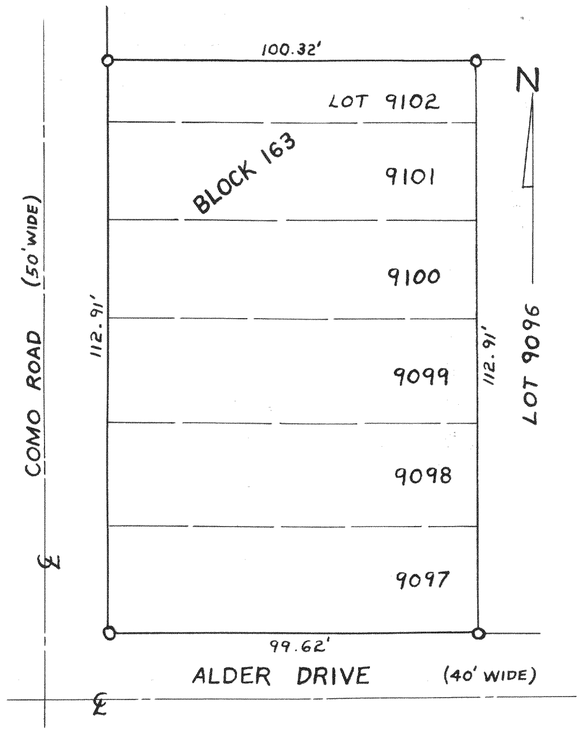

MAY, 1960 — Floyd L. Jensen — COUNTY SURVEYOR