

2726

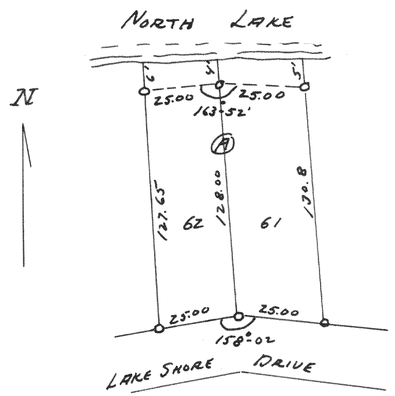


Plat of Survey of Lots 61 & 62
Block A Tract #1 North Lake Beach
T 3N R 16E
June, 1953 LLJ CS

2727

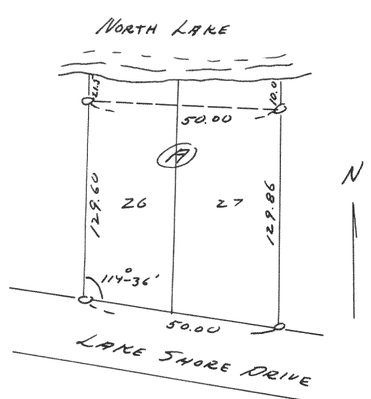


Plat of Survey of Lot 26 & 27
Block A Tract #2 North Lake Beach
T 3N R 16E
June, 1953 LLJ CS

2728

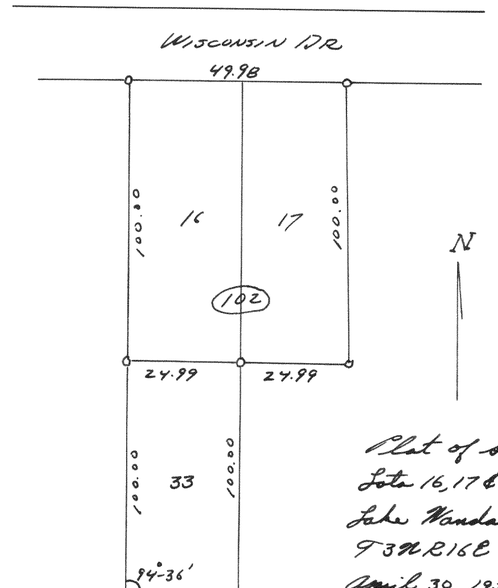


Plat of Survey of
Lots 16, 17 & 33 Block 102
Lake Wandawega Sub.
T 3N R 16E
April 30, 1953 LLJ CS

2729

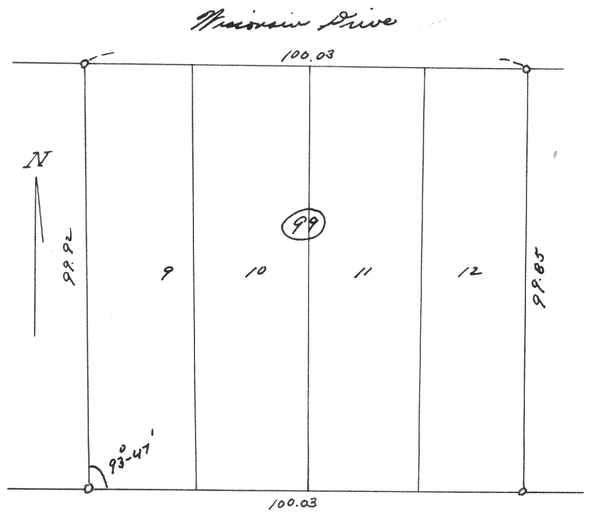


Plat of Survey of Lots 9-12 (incl) Blk 99
Lake Wandawega Sub T 3N R 16E
April, 1953 LLJ CS

2730

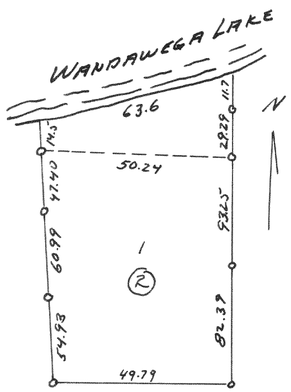

Plat of Survey of Lot 1 Block 2
Lake Wandawega Highlands T 3N R 16E
Sept 1953 LLJ CS

2731

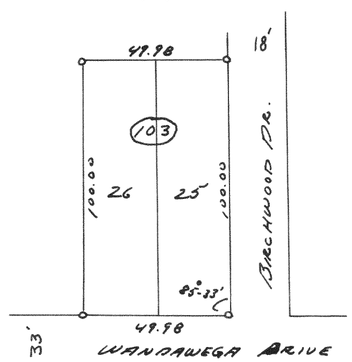

Plat of Survey of Lots 25 & 26
Block 103 Lake Wandawega Sub
T 3N R 16E
Sept. 1953 LLJ CS