
290

#3937

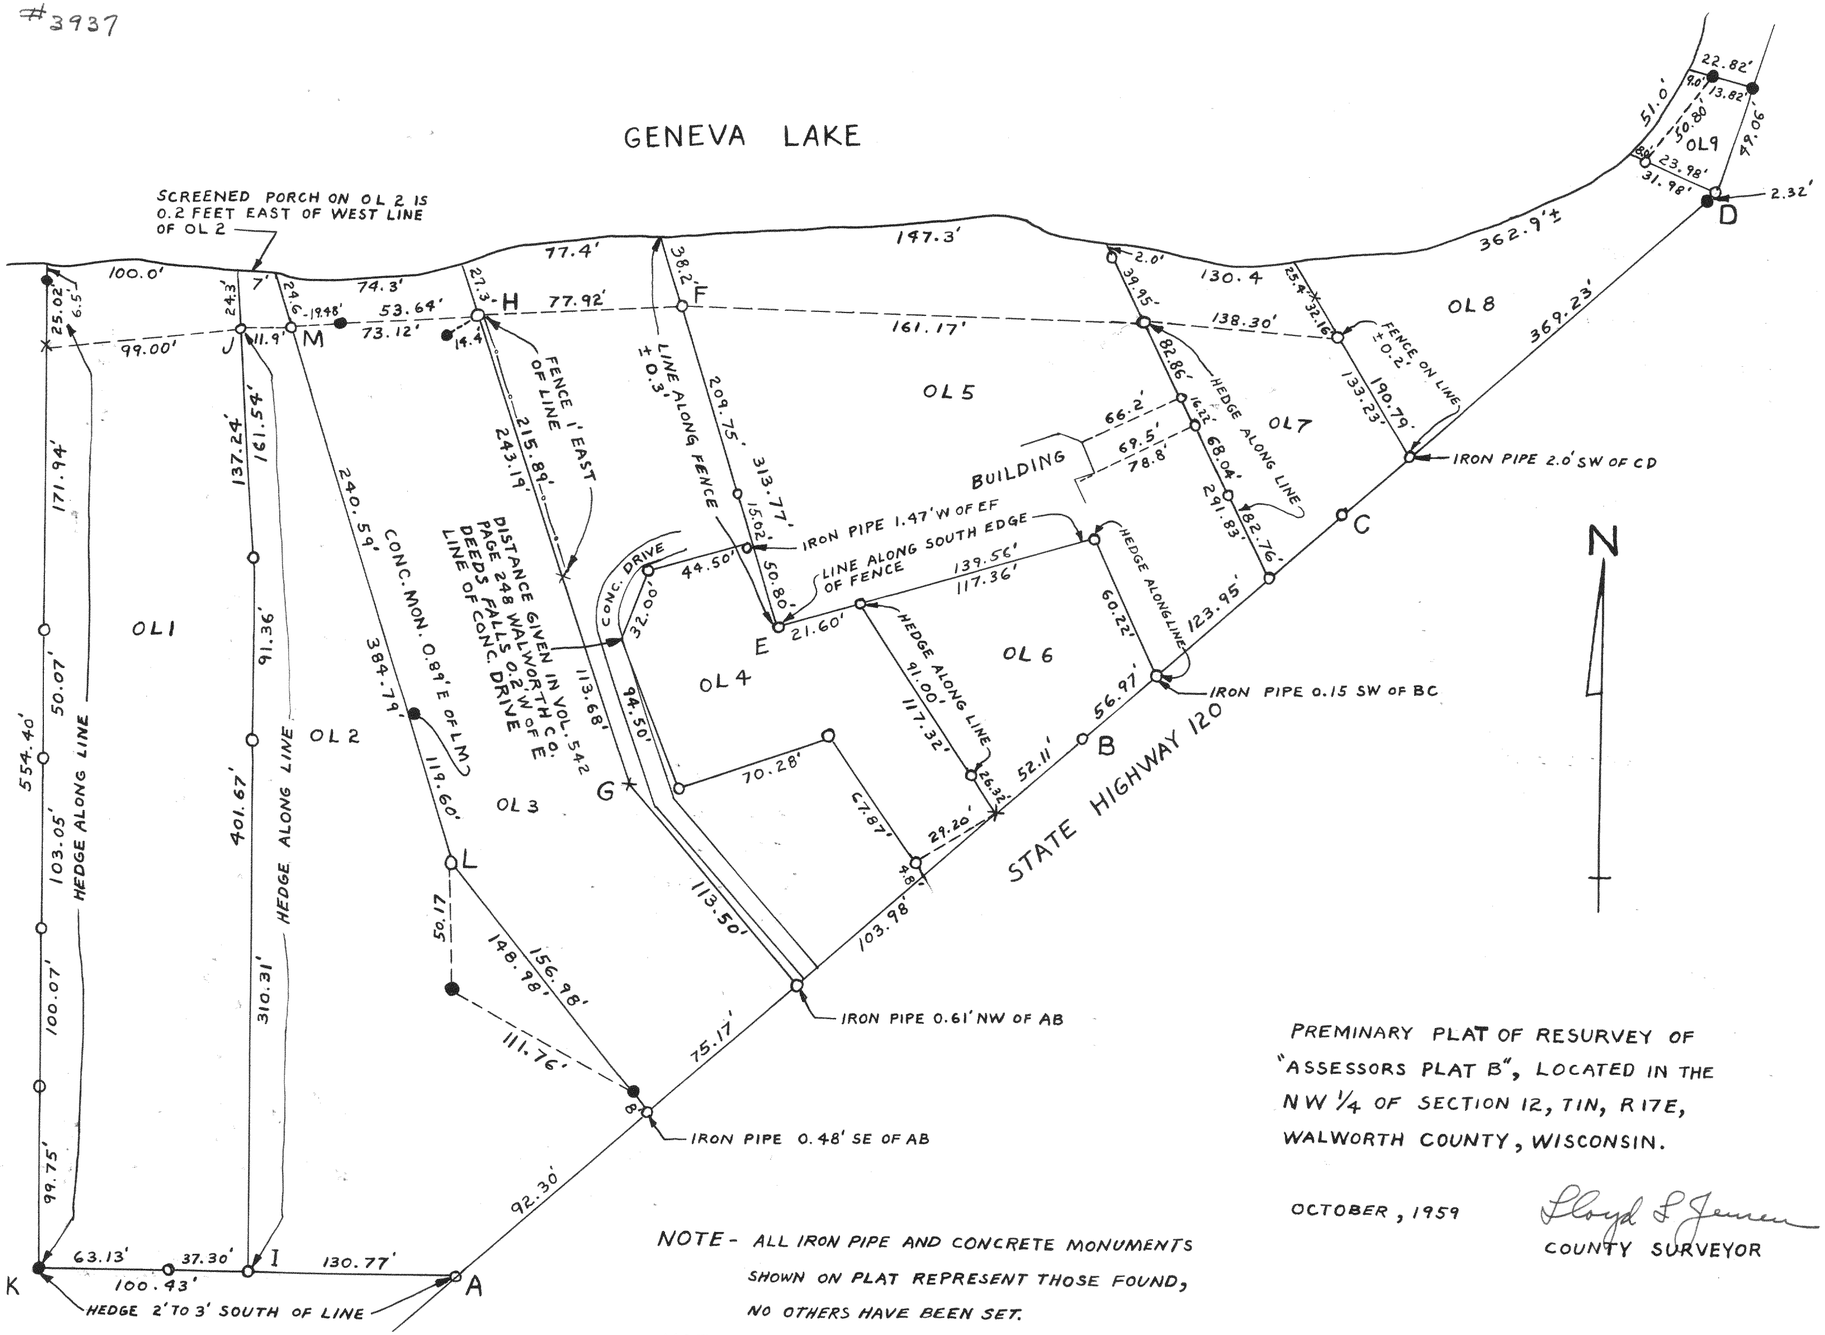

NOTE - ALL IRON PIPE AND CONCRETE MONUMENTS SHOWN ON PLAT REPRESENT THOSE FOUND, NO OTHERS HAVE BEEN SET.

NOTE - LINES CD, GH, IJ, AND AK ARE NOT STAIGHT LINES.

PREMINARY PLAT OF RESURVEY OF "ASSESSORS PLAT B", LOCATED IN THE NW 1/4 OF SECTION 12, T1N, R17E, WALWORTH COUNTY, WISCONSIN.

OCTOBER, 1959

Lloyd L Jensen
COUNTY SURVEYOR