

#3944

PLAT OF SURVEY OF A PARCEL OF LAND LOCATED IN THE EAST ½ OF SECTION 21, T1N, R18E, WALWORTH COUNTY, WISCONSIN.

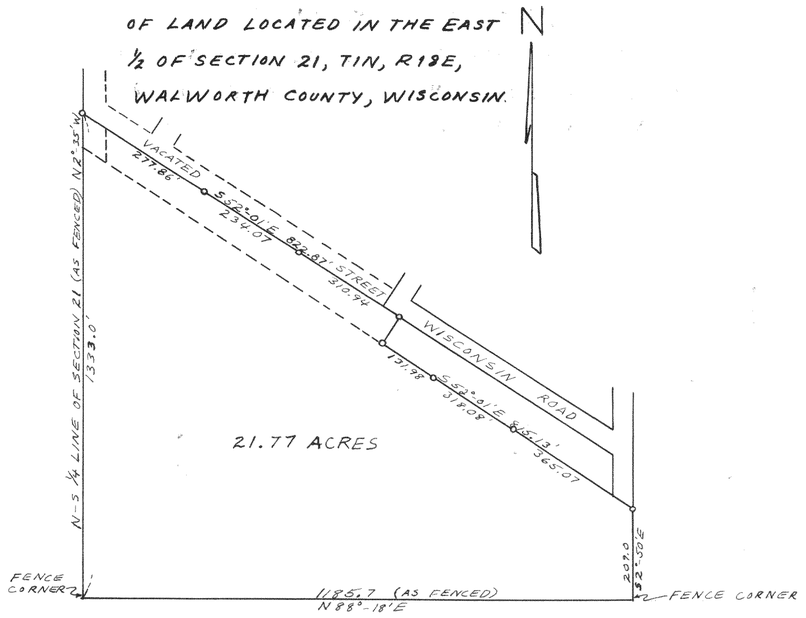

DECEMBER 1960 Floyd L Jensen
COUNTY SURVEYOR


#3945

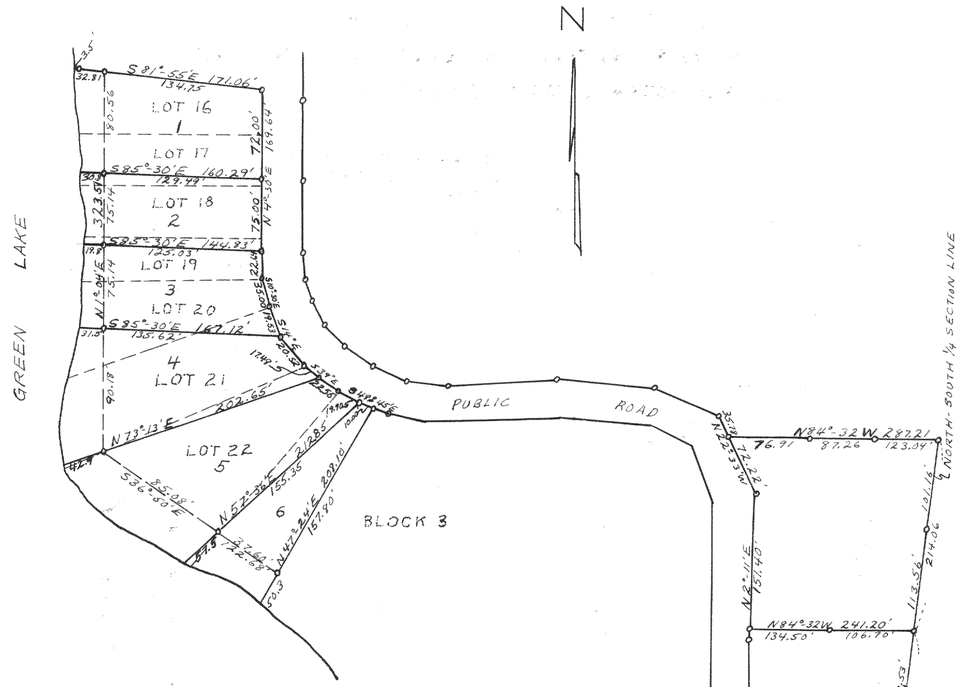

PLAT OF SURVEY OF LANDS LOCATED IN THE SOUTHWEST ¼ OF SECTION 26, T4N, R16E, WALWORTH COUNTY, WISCONSIN

NOVEMBER, 1960 Floyd L Jensen
COUNTY SURVEYOR

#3946

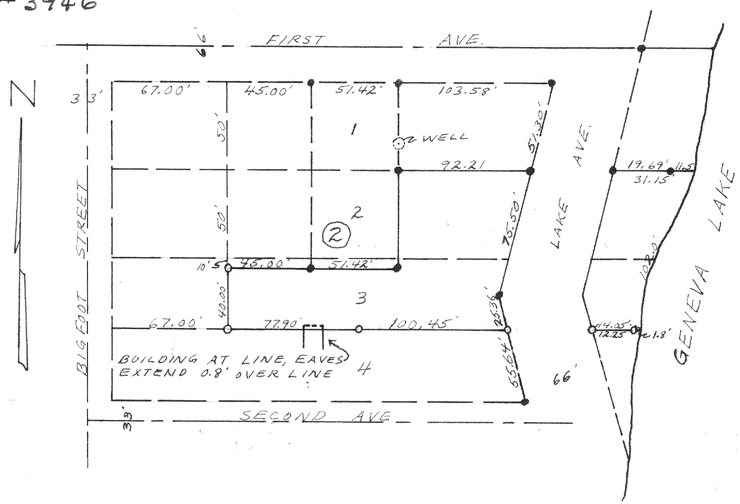

PLAT OF SURVEY OF PART OF LOTS 2 AND 3, BLOCK 1, D.A. REIDS ADDITION TO REIDS PARK SUBDIVISION

AUGUST 3, 1960 Floyd L Jensen
COUNTY SURVEYOR