
3956

Plat of survey of part of lots 1, 2 and 3, of Roughwood Park Subdivision and Unplatted lands in Section 36, T4N R16E, of Walworth County, Wisconsin (Described as parcels 1, 2 and 3 in Contract Oct 1960


Lloyd L. Jensen
County Surveyor
Lauderdale Lake
(Mill Lake)

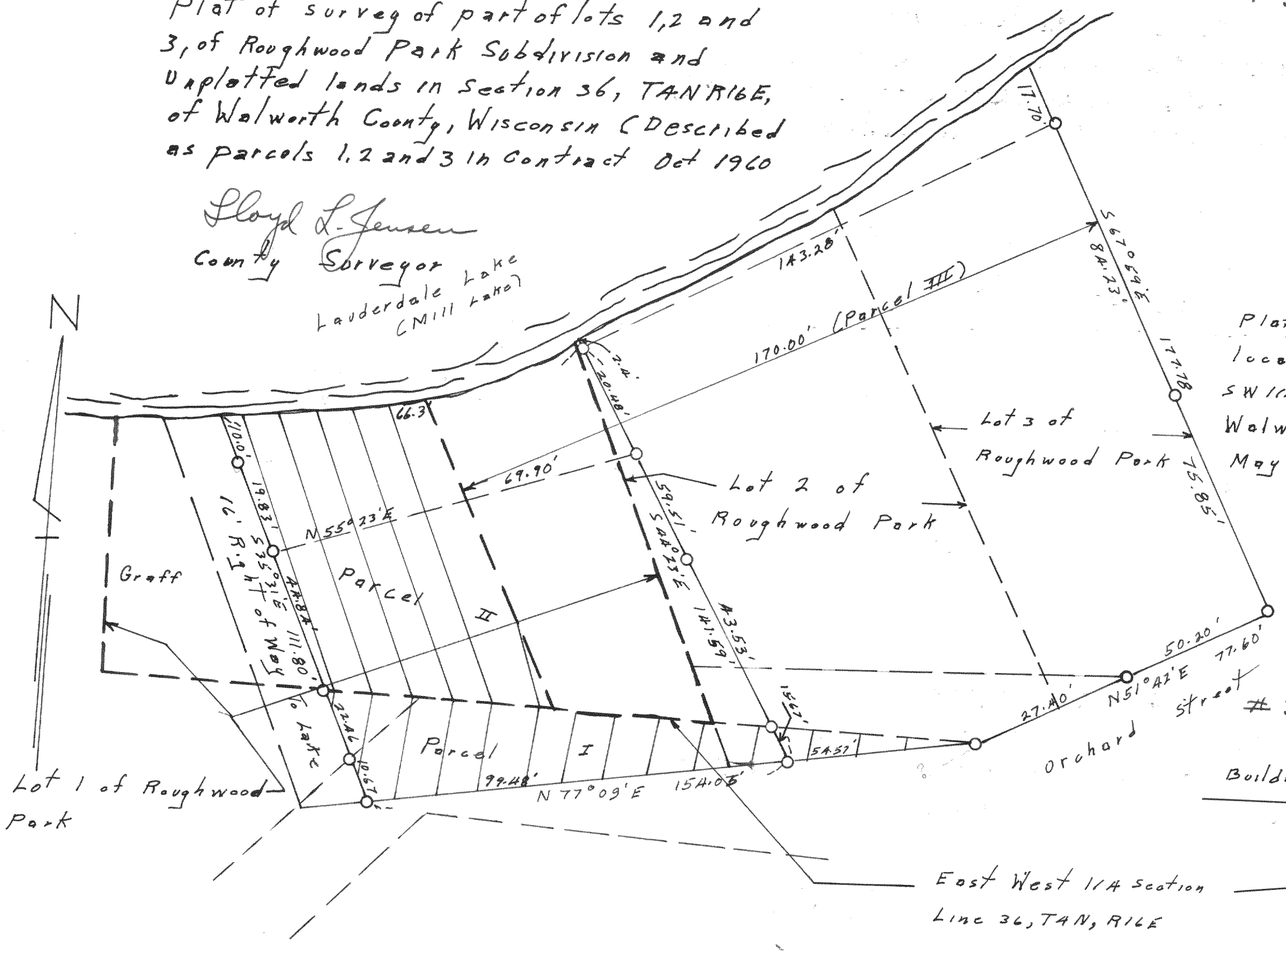

3957

Plat of survey of land located in the SW 1/4 of SW 1/4 of Section 22, T1N R16E Walworth County Wisconsin May 1960

Lloyd L Jensen
County Surveyor

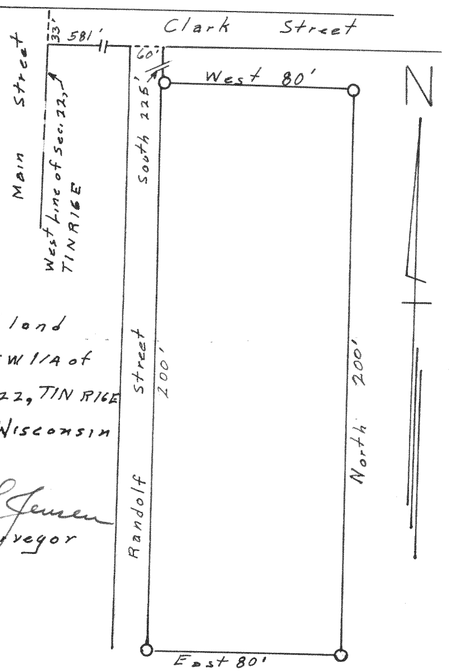

3958

Plat of survey of part of Lot 1, block 8, Original plat of the Village (now city) of Whitewater, Walworth County Wisconsin Dec. 1960

Lloyd L Jensen
County Surveyor

