
2732

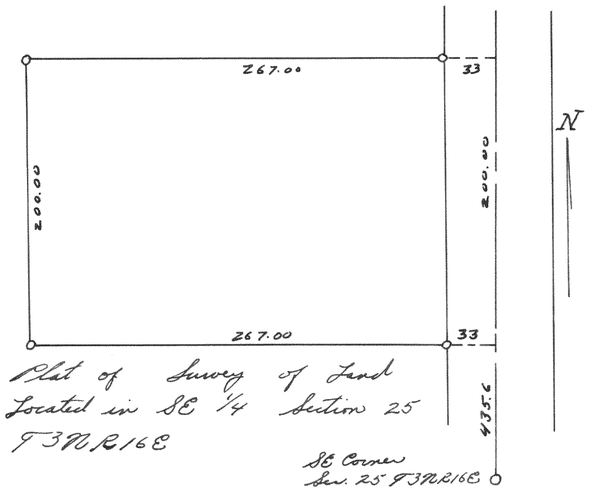


Plat of Survey of Land
Located in SE 1/4 Section 25
T3N R16E

Oct, 1953

LLJ
CS

2733

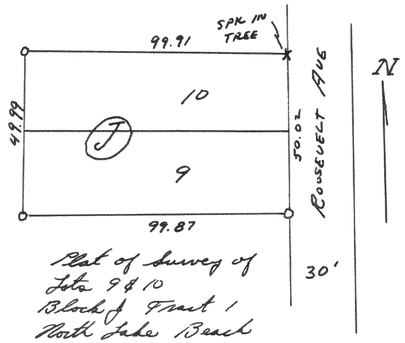


Plat of Survey of
Lots 9 & 10
Block J Tract 1
North Lake Beach
T3N R16E

Oct 21, 1953

LLJ
CS


2734

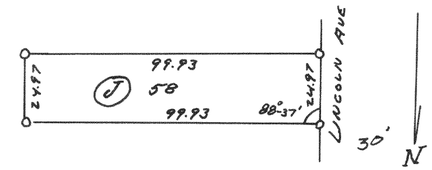

Plat of Survey of Lot 58
Block J Tract 1 North Lake Beach
T3N R16E
Oct, 1953

LLJ
CS


2735

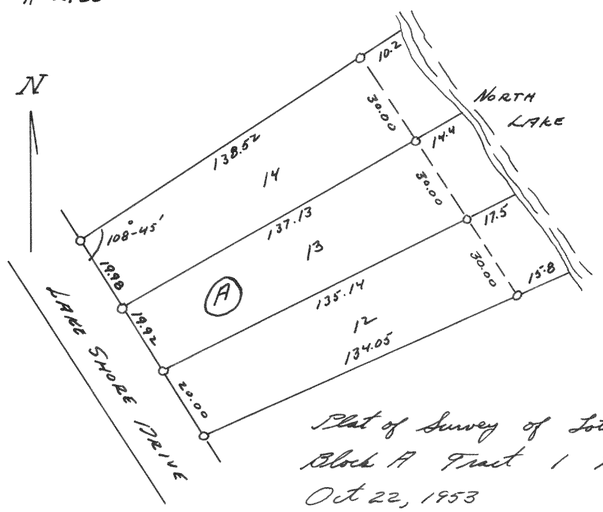

Plat of Survey of Lots 12 & 14
Block A Tract 1 North Lake Beach
Oct 22, 1953

LLJ
CS

2736

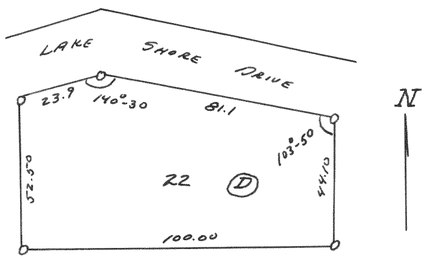


Plat of Survey of Lot 22
Block D Tract 1 North Lake Beach
T3N R16E

June 29, 1953

LLJ
CS

2737

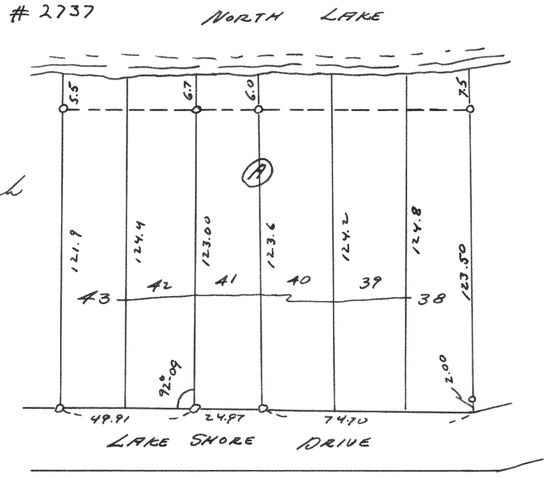

Plat of Survey of Lot 38-43 (INCL)
Block A Tract 1 North Lake Beach
T3N R16E
July 1953

LLJ
CS