

#3964

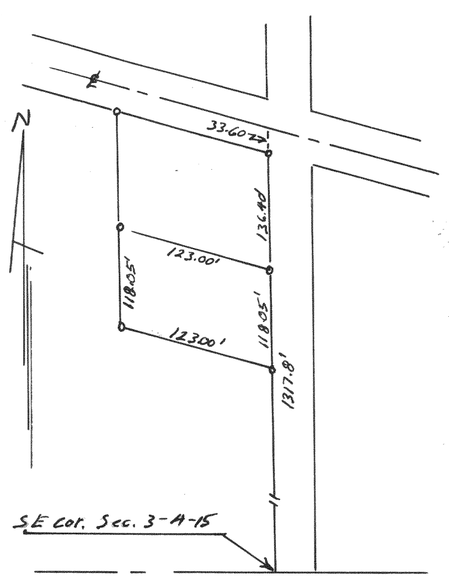


Survey of parcel in SE¼ Sec 3-4-15
Feb 10, 1960 Floyd L. Jensen
Wal. Co Surveyor

#3965

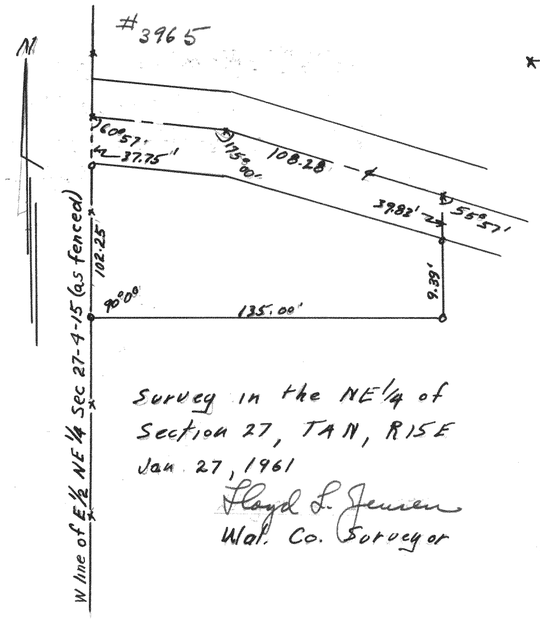


Survey in the NE¼ of Section 27, T4N, R15E
Jan 27, 1961 Floyd L. Jensen
Wal. Co. Surveyor

#3966

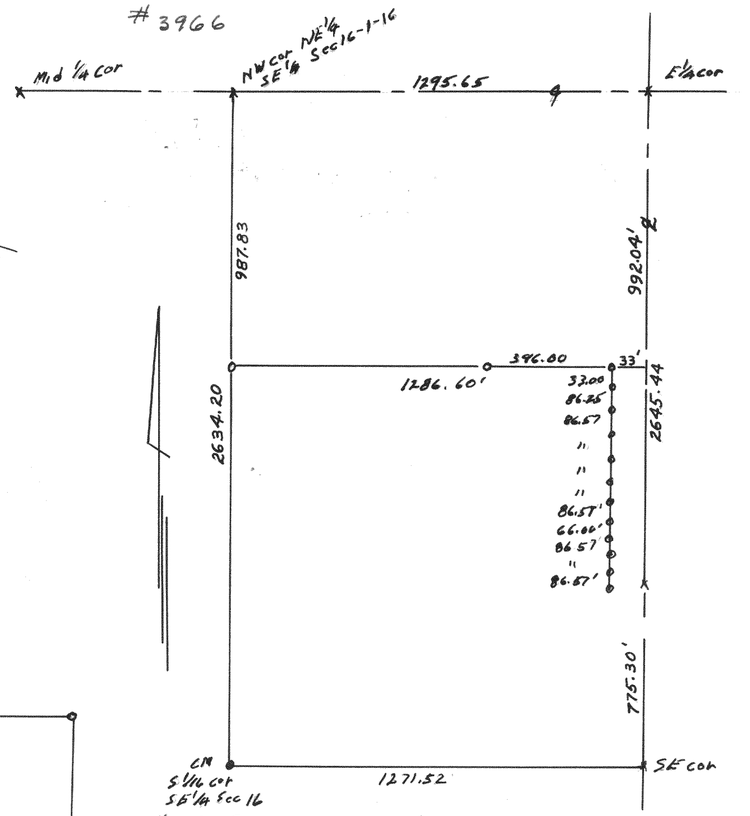


#3969
Survey in NE¼ SE¼ Sec 16-1-16
Apr. 1960, 1960 Floyd L. Jensen
Wal Co. Surveyor

#3967

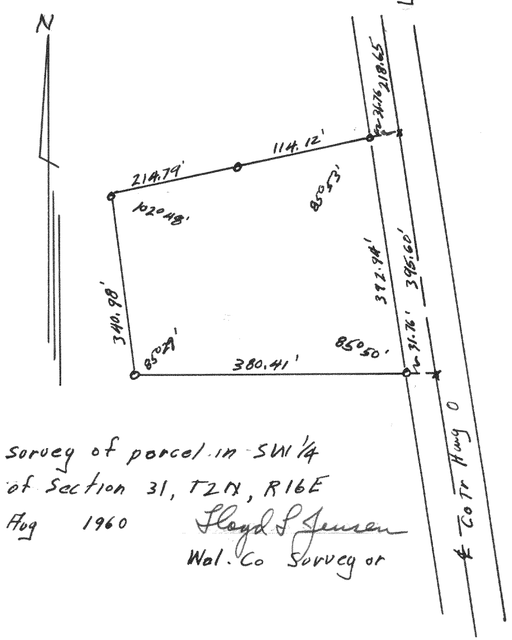


Survey of parcel in SW¼ of Section 31, T2N, R16E
Aug 1960 Floyd L Jensen
Wal. Co Surveyor

#3968

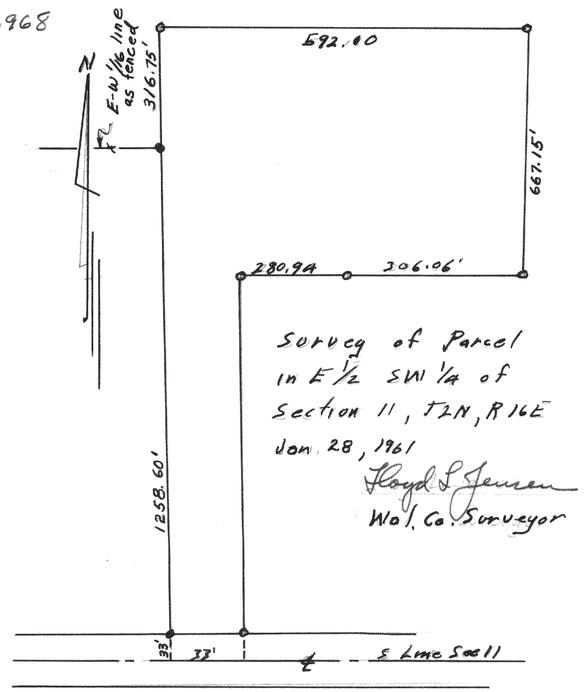

Survey of Parcel in E½ SW¼ of Section 11, T2N, R16E
Jan 28, 1961 Floyd L Jensen
Wal. Co. Surveyor

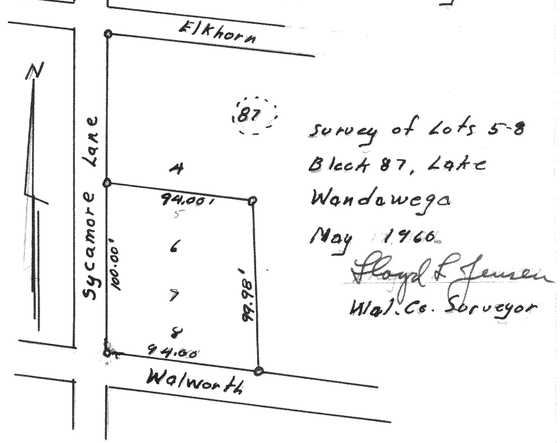

Survey of Lots 5-8 Block 87, Lake Wandawega
May 1960
Floyd L Jensen
Wal. Co. Surveyor