
302


#3970

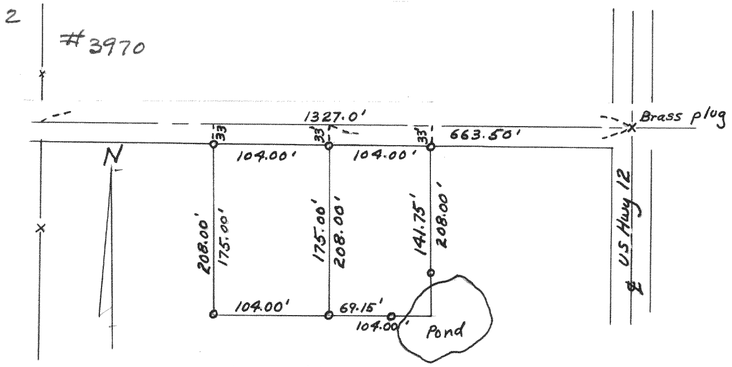

Survey in NE 1/4 SE 1/4 of Sec 24, T3N, R16E
Oct 24, 1960

Floyd L. Jensen
Wal. Co. Surveyor


#3971

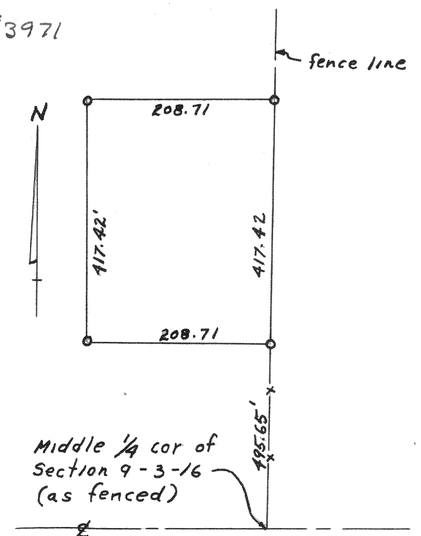

Survey in SE 1/4 NW 1/4 Sec 9-3-16
Mar 22, 1961

Floyd L. Jensen
Wal. Co. Surveyor


#3972

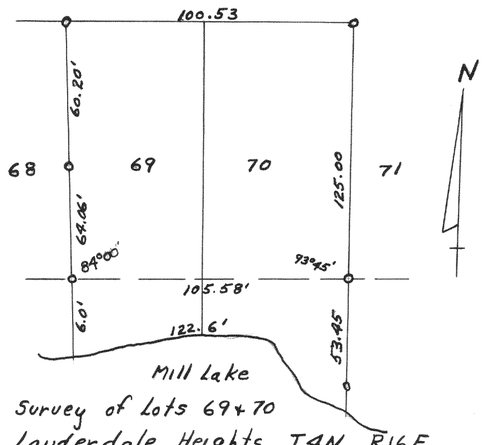

Survey of Lots 69+70
Lauderdale Heights T4N, R16E
July 14, 1960

Floyd L Jensen
Wal. Co. Surveyor


#3973

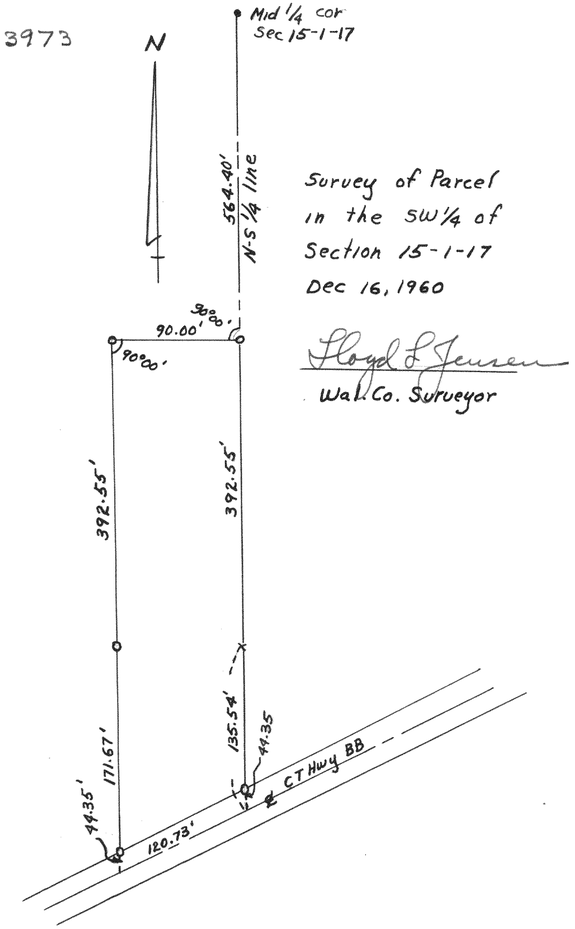

Survey of Parcel in the SW 1/4 of Section 15-1-17
Dec 16, 1960

Floyd L Jensen
Wal. Co. Surveyor

#3974

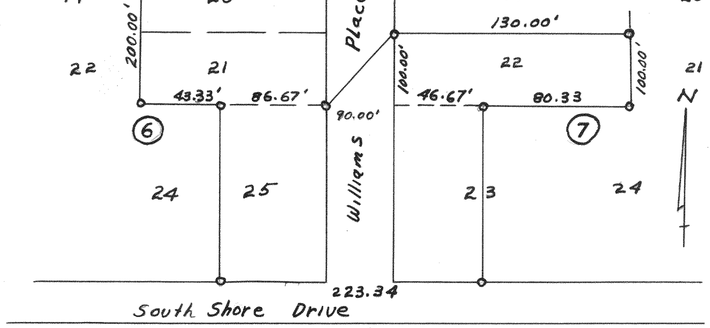


Survey of Part of Blocks 6 & 7, Lake Geneva Terrace. T1N, R17E

Aug 18, 1960

Floyd L. Jensen
Wal. Co. Surveyor

#3975

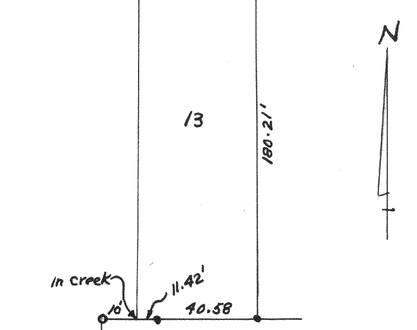

Survey of Lot 13, Lake Geneva Beach, T1N R17E

Sept. 15, 1960

Floyd L. Jensen
Wal. Co. Surveyor