

#3980

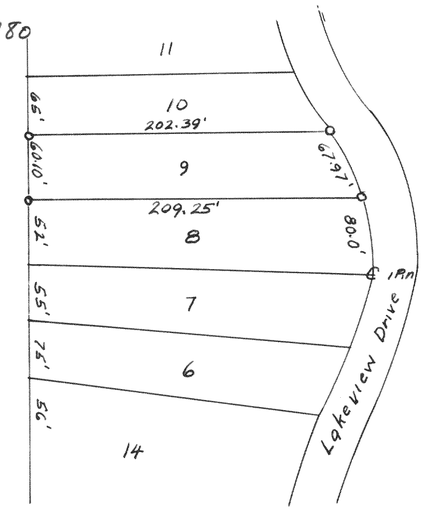


Survey of lot 9, Block 14,
Woodale Add, T 1N, R 17 E
Date 10-14-59
Floyd L Jensen
(County Surveyor)

#3981

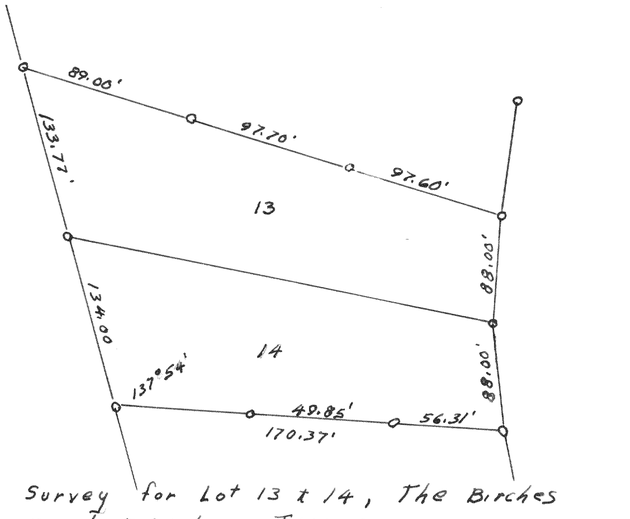


Survey for Lot 13 & 14, The Birches
First Addition, T1N, R17E
Date 11-1-61
Floyd L Jensen
(County Surveyor)

#3982

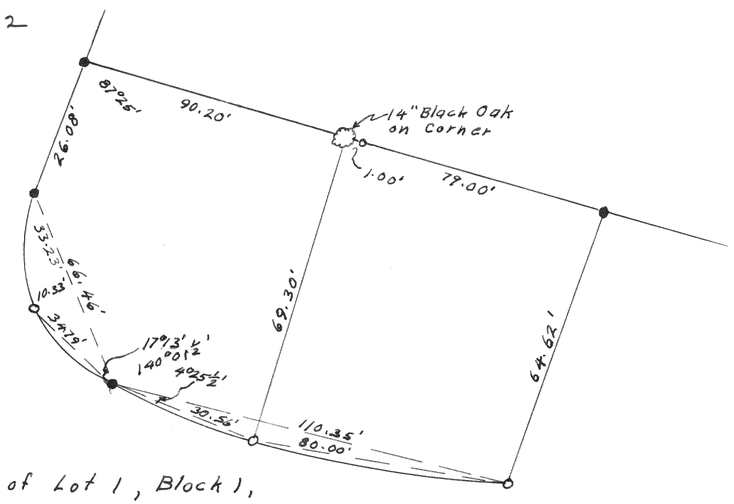

Survey of Lot 1, Block 1,
Woodale Addition, T1N, R17E
Date 9-14-61
Floyd L. Jensen
(County Surveyor)

#3983

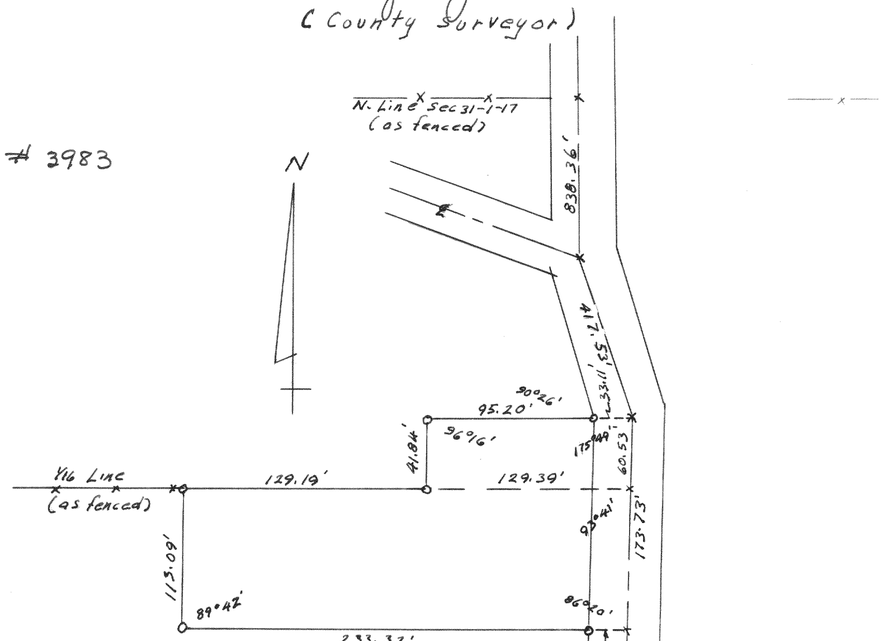

Survey in NE¼ of Section 31, T1N, R17E
Mickle School

Date 11-9-61
Floyd L Jensen
(County Surveyor