

#3984

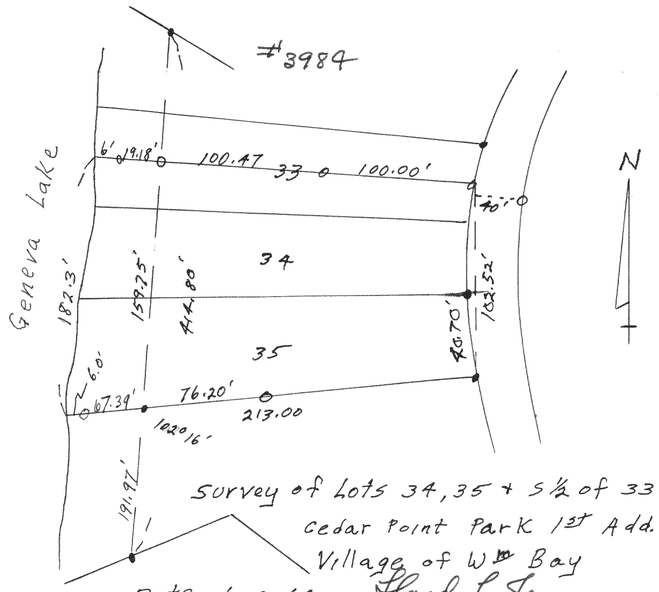


Survey of Lots 34, 35 + S½ of 33
Cedar Point Park 1st Add.
Village of W^ms Bay
Date 6-2-60 Floyd L. Jensen
(county Surveyor)

#3985 Highland Road

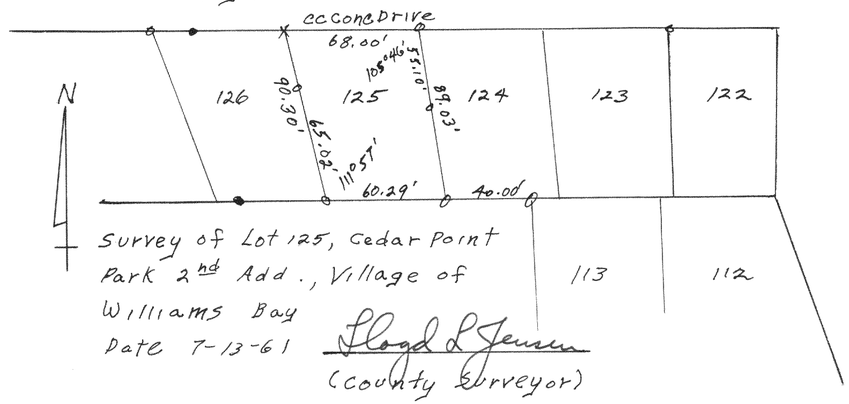


Survey of Lot 125, Cedar Point
Park 2nd Add., Village of
Williams Bay
Date 7-13-61 Floyd L Jensen
(county Surveyor)

#3986

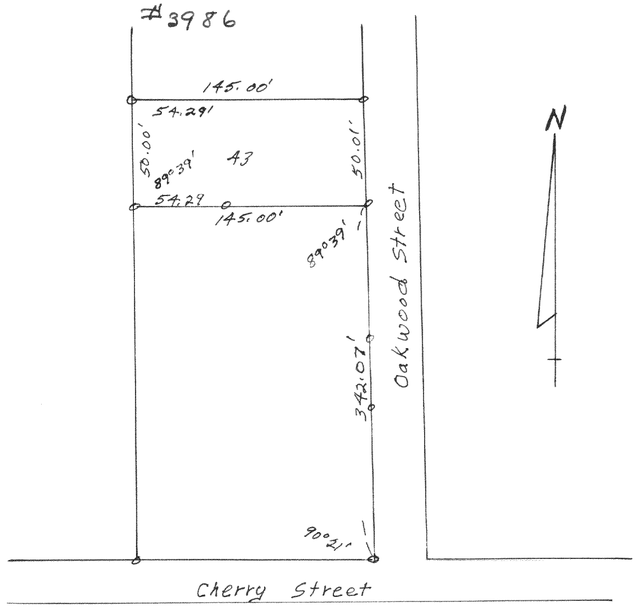

Survey of Lot 43, Lockwood Subd,
Village of Williams Bay
Date 8-16-60 Floyd L. Jensen
(county Surveyor)

#3987

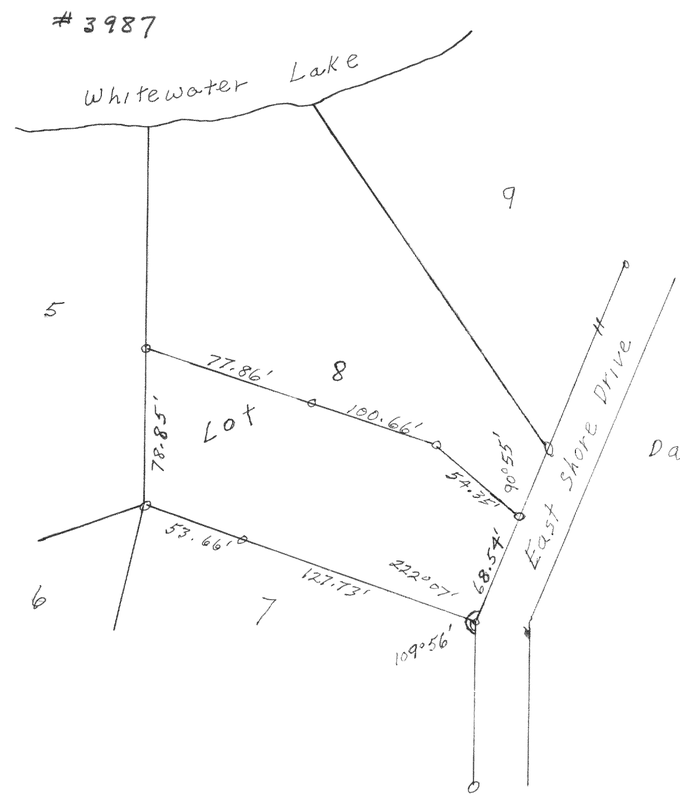

Survey of part of Lot 8,
Thorne Heights, T4N, R15E
Date 11-8-61 Floyd L. Jensen
(county Surveyor)