

#3988

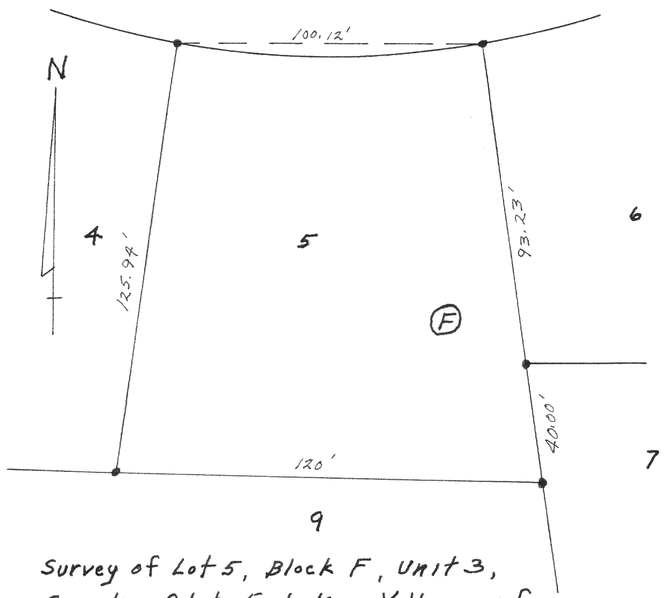


Survey of Lot 5, Block F, Unit 3, Country Club Estimates, Village of Fontana-on-Geneva Lake
Date 8-10-61 Floyd L Jensen
(County Surveyor)

#3989

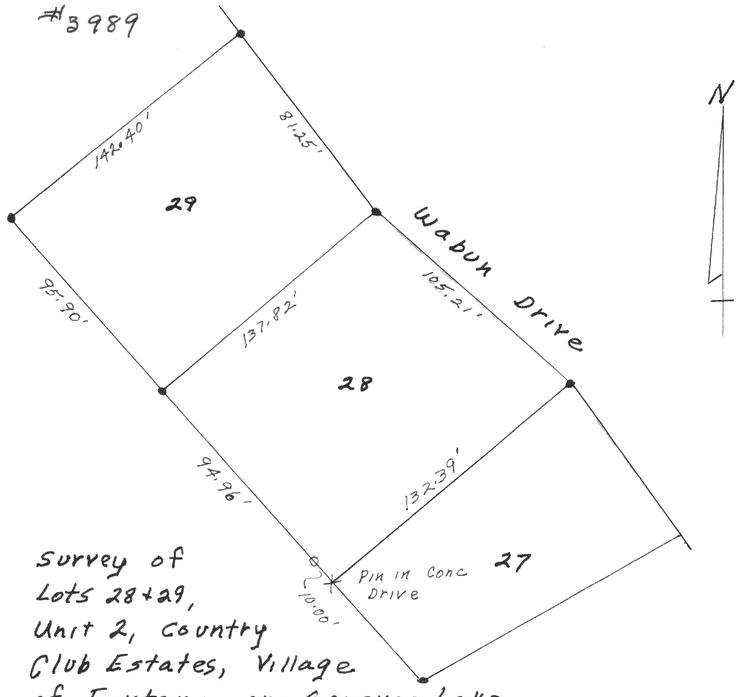


Survey of Lots 28+29, Unit 2, Country Club Estimates, Village of Fontana-on-Geneva-Lake
Date 11-7-61 Floyd L Jensen
(County Surveyor)

#3990

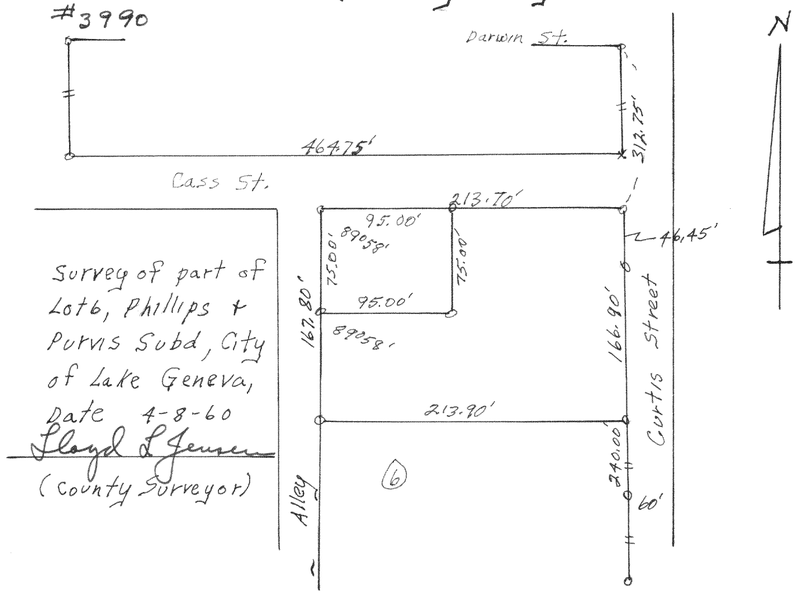

Survey of part of Lot 6, Phillips + Purvis Subd, City of Lake Geneva,
Date 4-8-60 Floyd L Jensen
(County Surveyor)

#3991

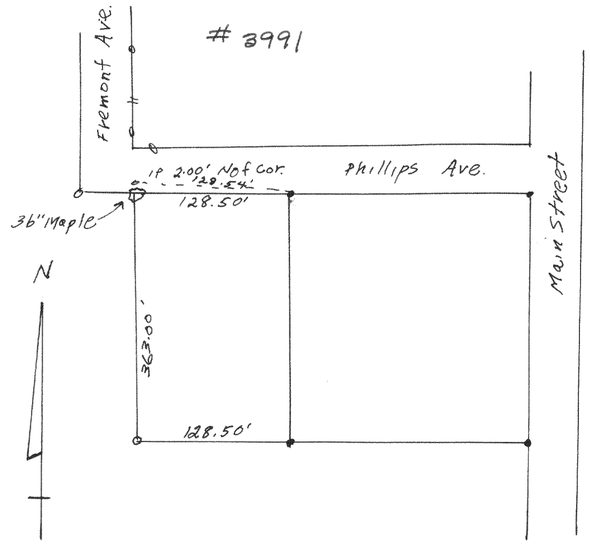

Survey in the SE 1/4 of Sec 21-1-16, Village of Walworth
Date 1-10-60 Floyd L Jensen
(County Surveyor)