

#3992

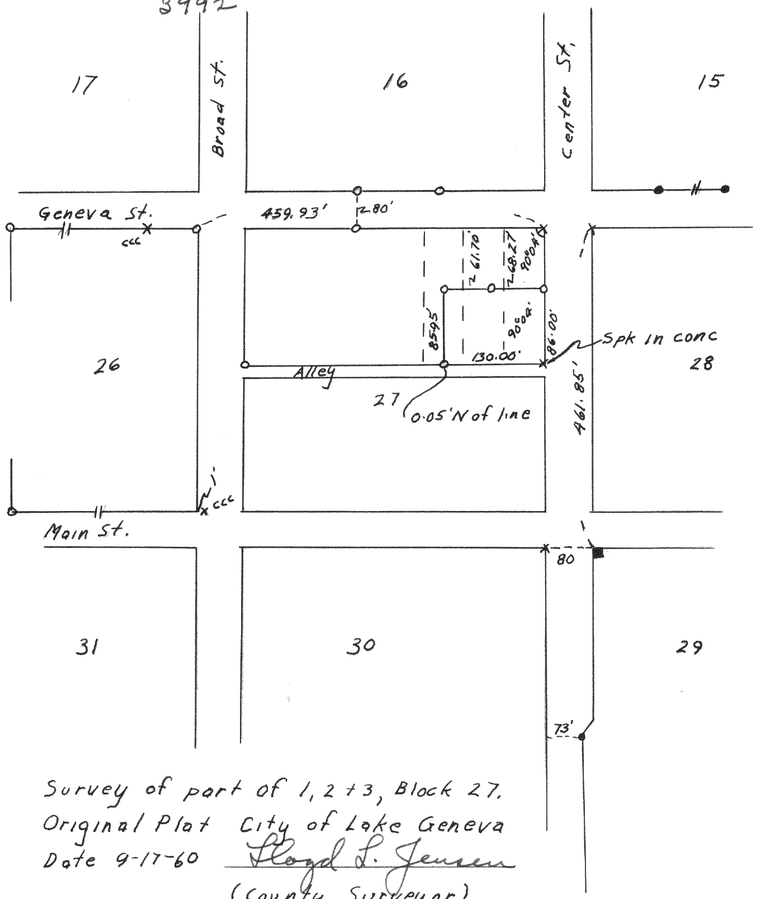


Survey of part of 1, 2 + 3, Block 27, Original Plat City of Lake Geneva
Date 9-17-60 Floyd L. Jensen
(County Surveyor)

#3993

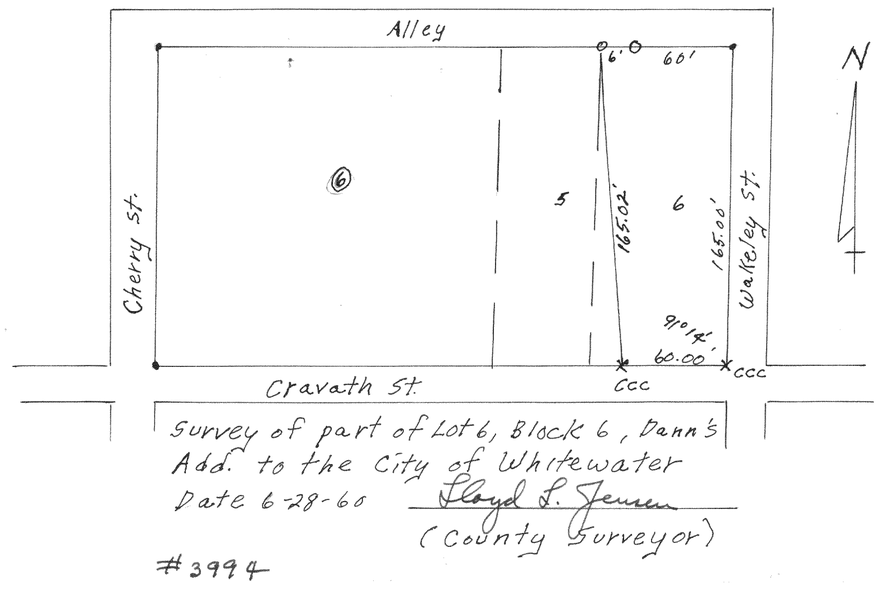

Survey of part of Lot 6, Block 6, Dann's Add. to the City of Whitewater
Date 6-28-60 Floyd L. Jensen
(County Surveyor)

#3994

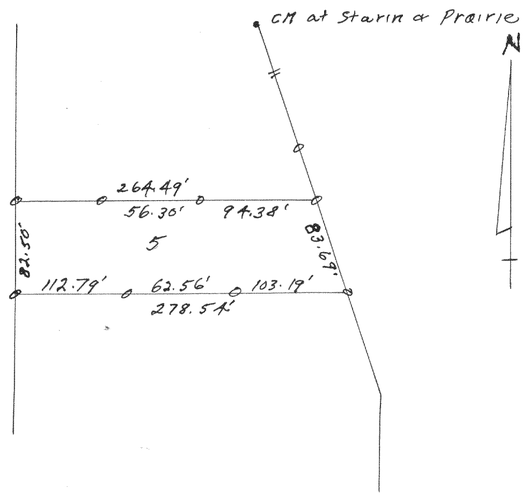

Survey of Part of Lot 5, F.L. Pratts Add. to the City of Whitewater
Date 8-8-60 Floyd L Jensen
(County Surveyor)