
#3995

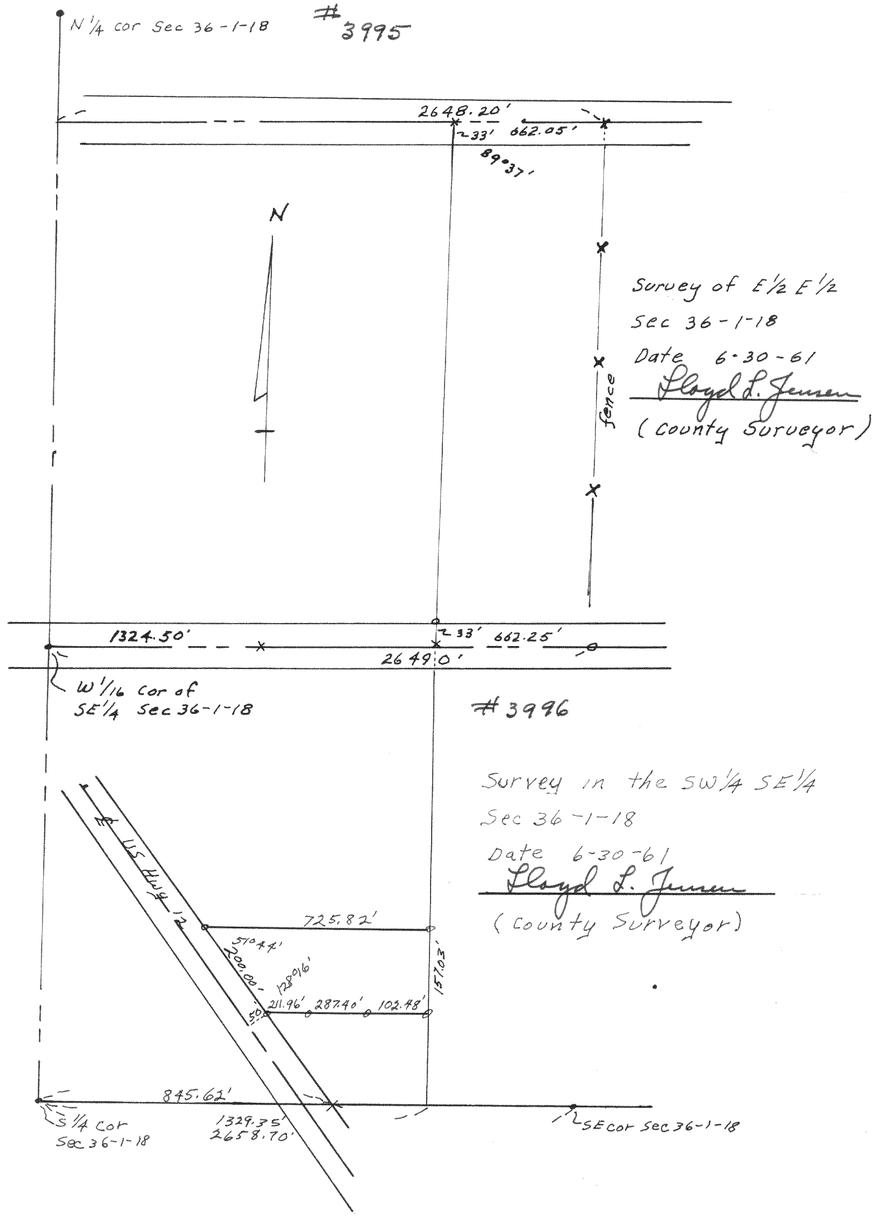


Survey of E½ E½
Sec 36-1-18
Date 6-30-61
Floyd L. Jensen
(County Surveyor)

#3996

Survey in the SW¼ SE¼
Sec 36-1-18
Date 6-30-61
Floyd L. Jensen
(County Surveyor)

#3997

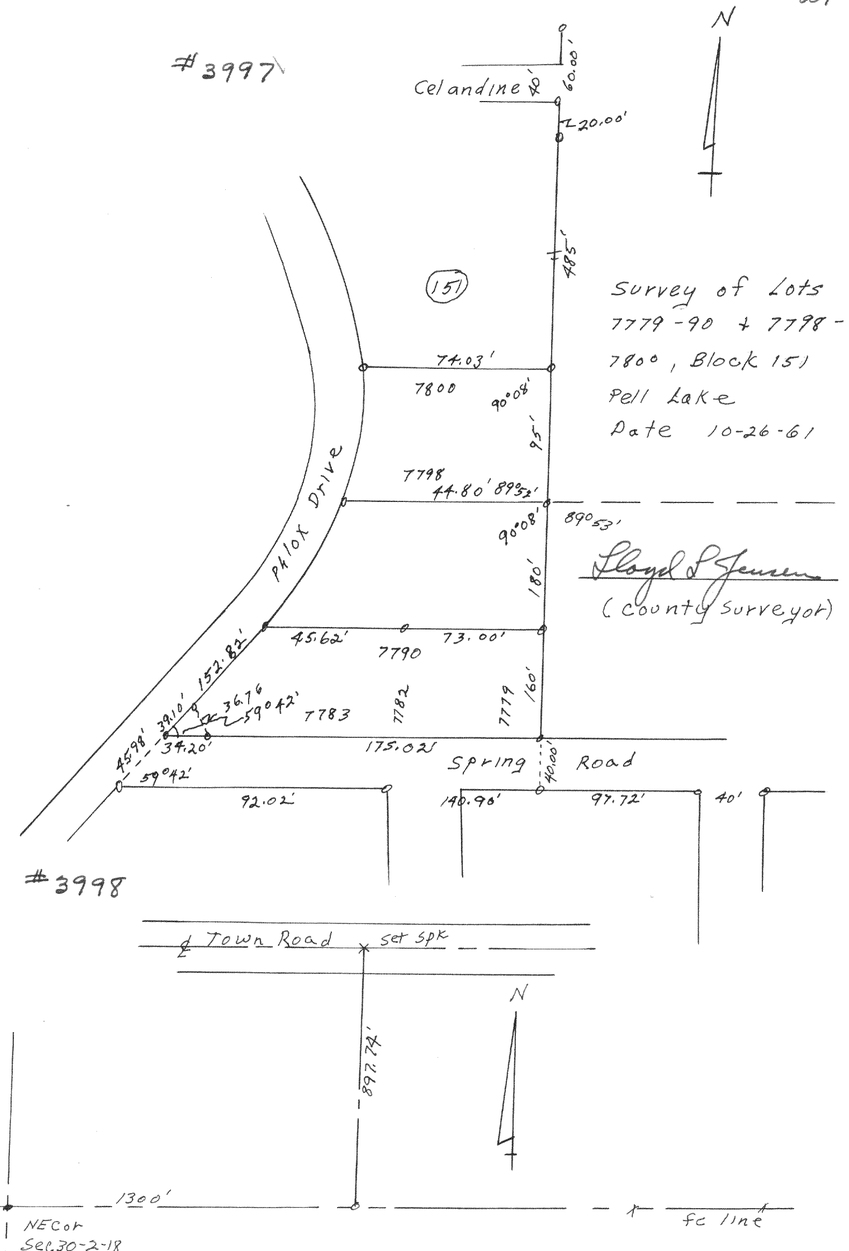

Survey of Lots
7779-90 + 7798-7800, Block 151
Pell Lake
Date 10-26-61
Floyd L Jensen
(County Surveyor)

Survey in SW¼ of Section 20-2-18
Date 11-29-61
Floyd L Jensen
(County Surveyor)