

#3999

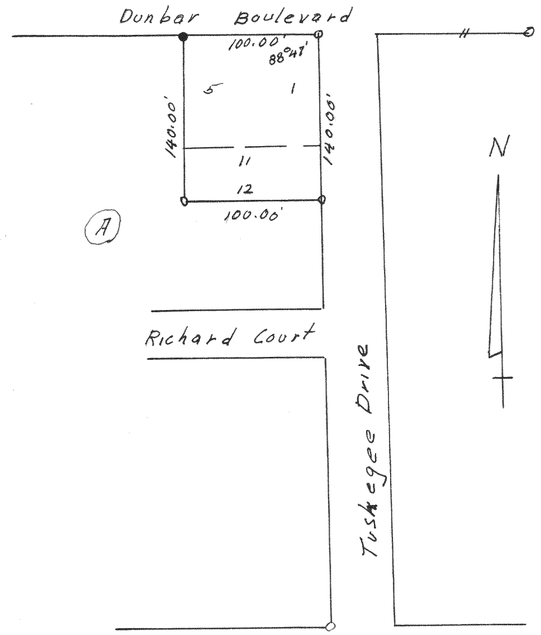

Washington Ave


Survey of Lots 1-5 & 11-12, Block A,
Lake Ivanhoe, T1N, R18E
Date 10-16-61 Lloyd L Jensen
(County Surveyor)

#4000

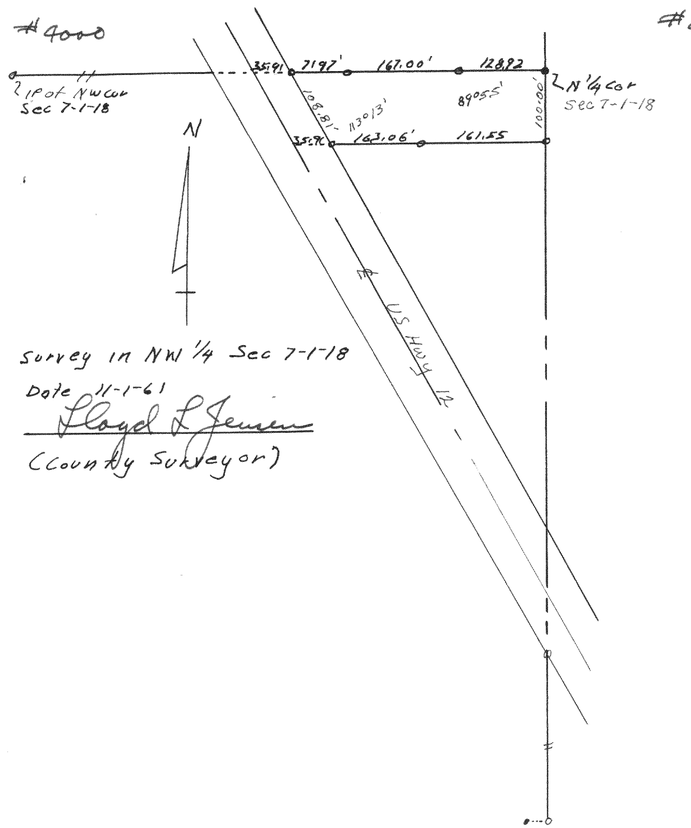


Survey in NW 1/4 Sec 7-1-18
Date 11-1-61 Lloyd L Jensen
(County Surveyor)

#4001

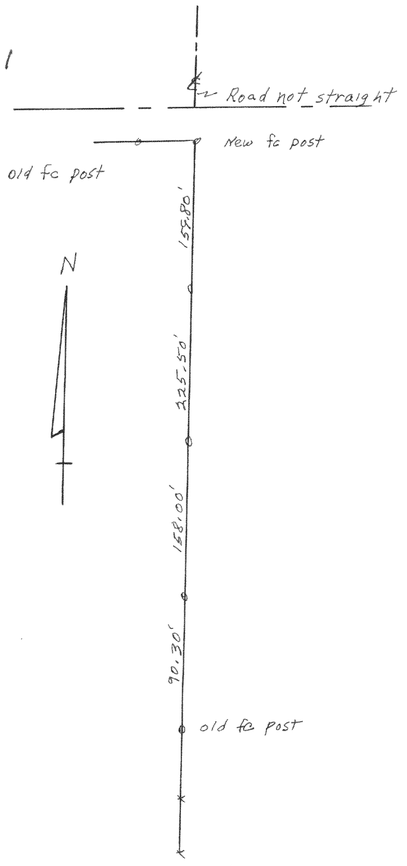

Survey of N-S 1/4 line
Section 24-2-18
Date 2-10-61 Lloyd L Jensen
(County Surveyor)

#4002

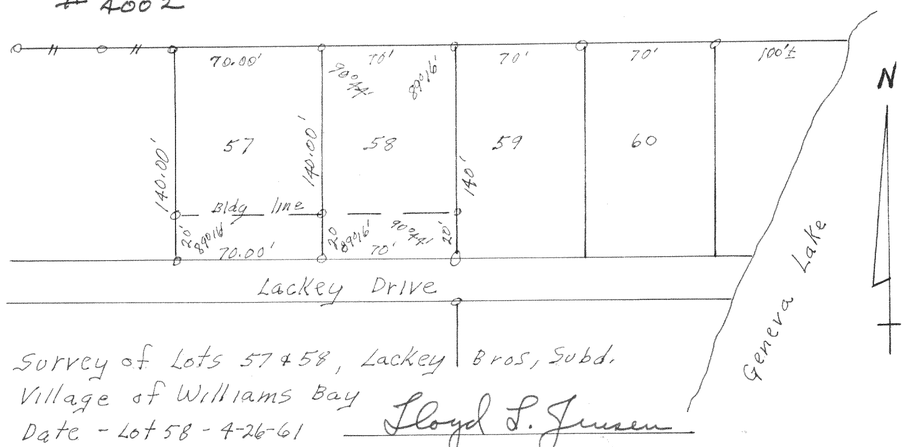

Survey of Lots 57 & 58, Lackey Bros, Subd.
Village of Williams Bay
Date - Lot 58 - 4-26-61 Lloyd L. Jensen
Lot 57 - 8-22-61 (County Surveyor)