

#4003

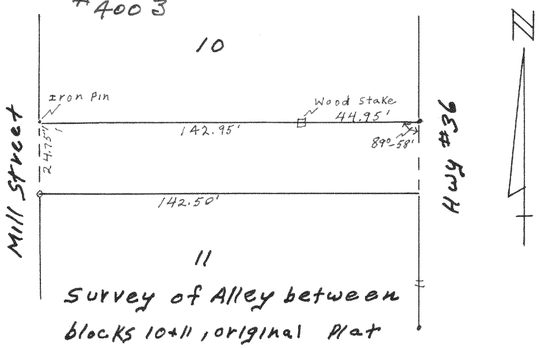

Survey of Alley between blocks 10+11, original Plat at the Village of Fontana-on-Geneva Lake date Aug. 1960

Floyd L Jensen
(County Surveyor)


#4004

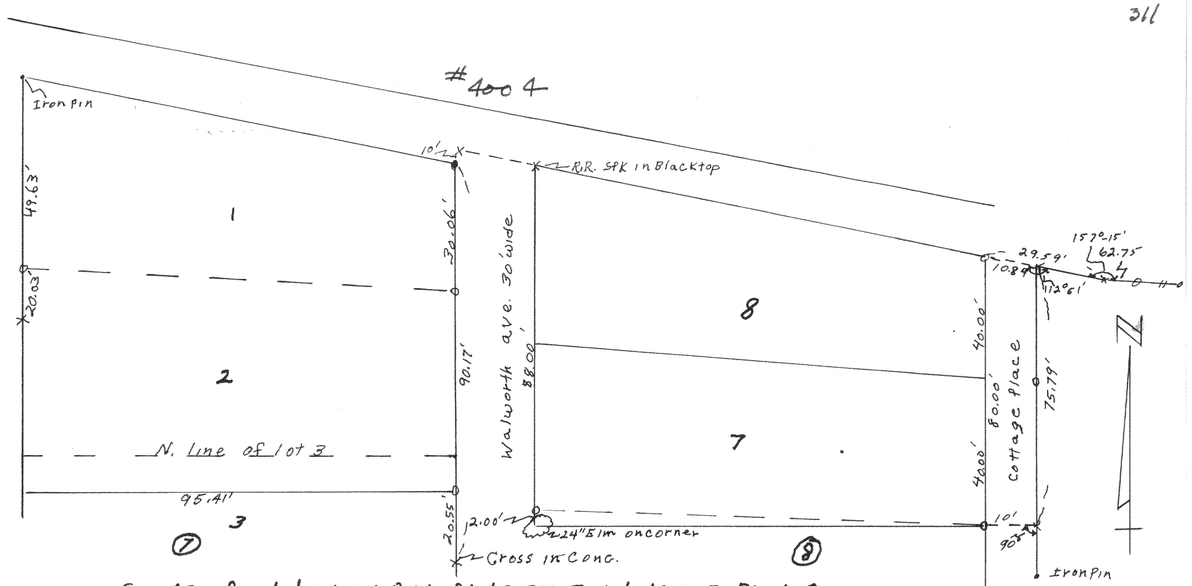

Survey for lots 1, 2 + part of lot 3 Blk 7 + lots 7+8, Block 8 Glenwood Springs, Village of Fontana Date 8-13-60

Floyd L Jensen
(County surveyor)


#4005

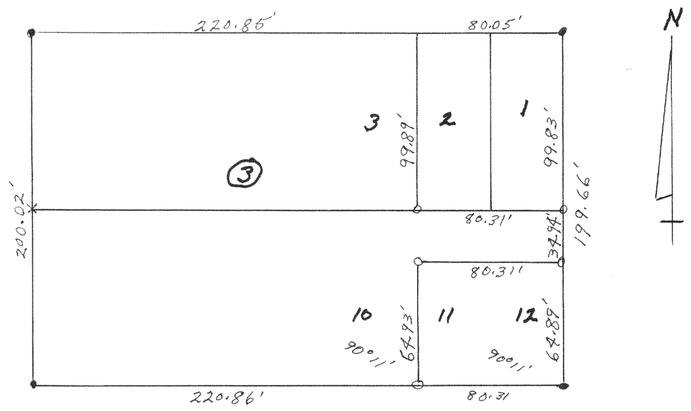

Survey of Lots 11+12, Block 3, D.A. Reid's Add, Village of Fontana
Date 7-7-61

Floyd L. Jensen
(County Surveyor)

#4006

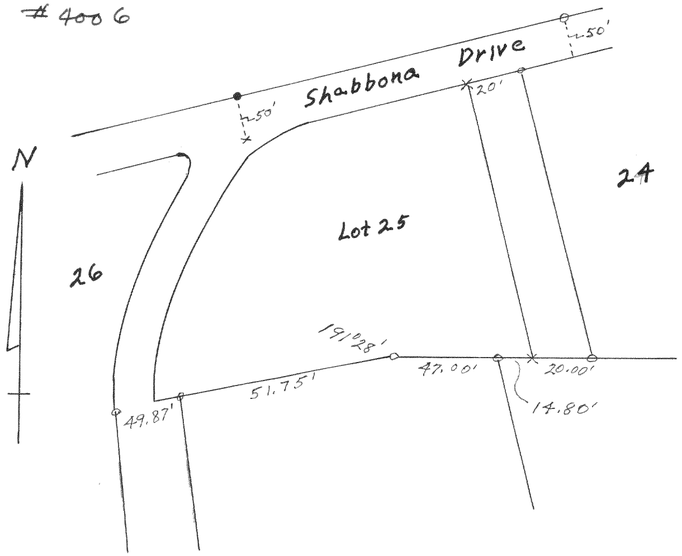

Survey of Lot 25, Unit 1, Country Club Estates, Village of Fontana-on-Geneva Lake
Date 4-19-60

Floyd L Jensen
(County Surveyor)