

#4012

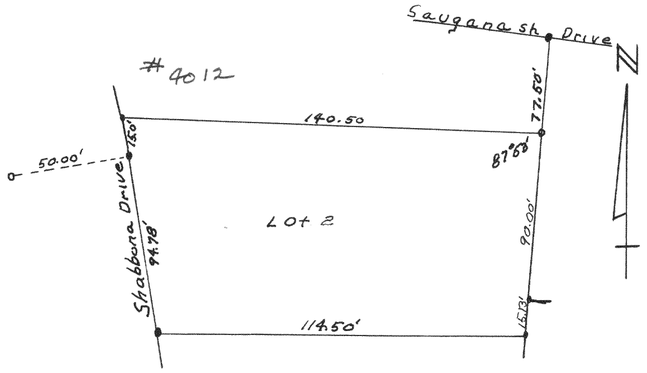


Survey of Lot 2 Block F, Unit 3, Country Club Estates
Village of Fontana
Date Jan, 1962
Floyd L Jensen
(County Surveyor)

#4013

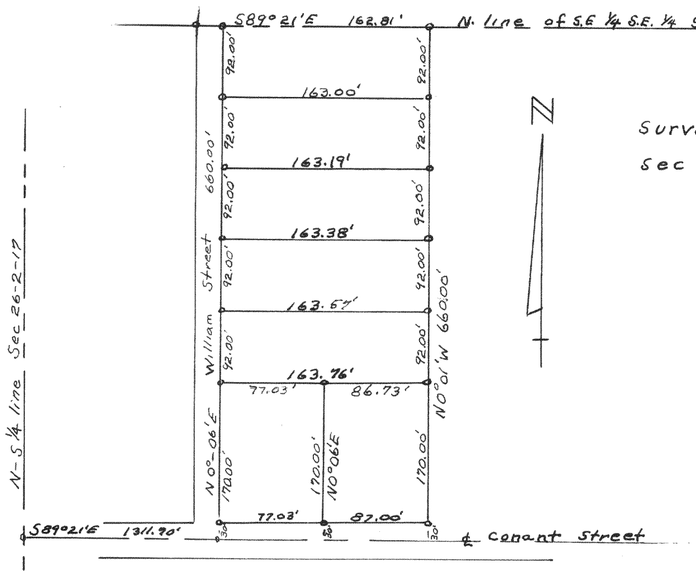


Survey of the W¼ N.W ¼ S.E. ¼ S.E ¼
Sec 26-2-17 City of Lake Geneva
Floyd L Jensen
(County Surveyor
Date Oct. 1961

#4014

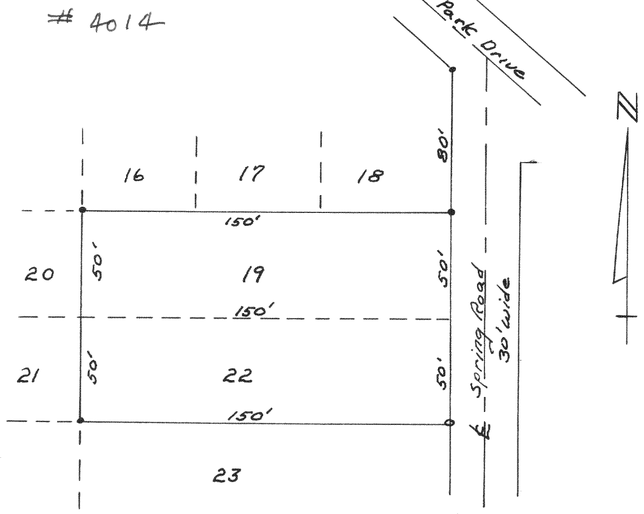

Survey of Lots 19+22 of Lake Geneva Beach Subd.
Sec. 11-1-17
Floyd L. Jensen
(County Surveyor)
Date Sept. 1961

#4015

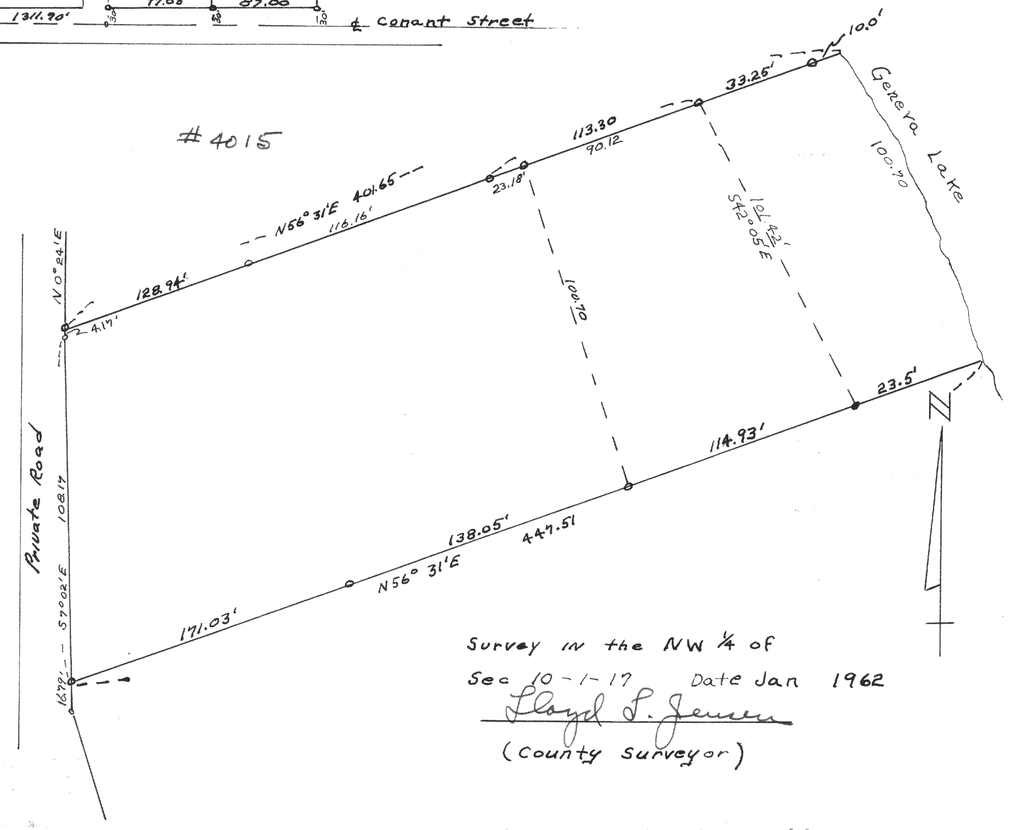

Survey in the NW ¼ of
Sec 10-1-17 Date Jan 1962
Floyd L. Jensen
(County Surveyor)