

#4016

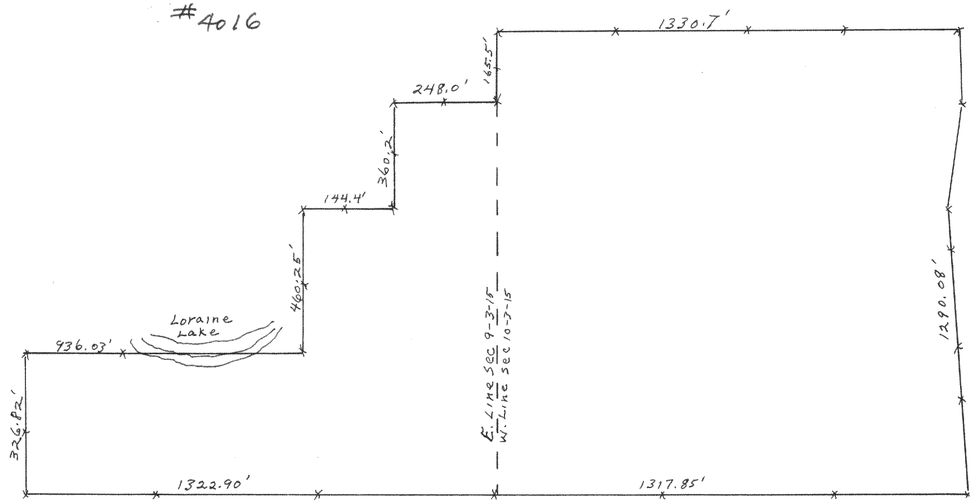

Survey in the NE 1/4 sec 9-3-15
and the NW 1/4 sec 10-3-15 (as fenced)
Lloyd L Jensen (county surveyor) Date Dec. 1961

#4017

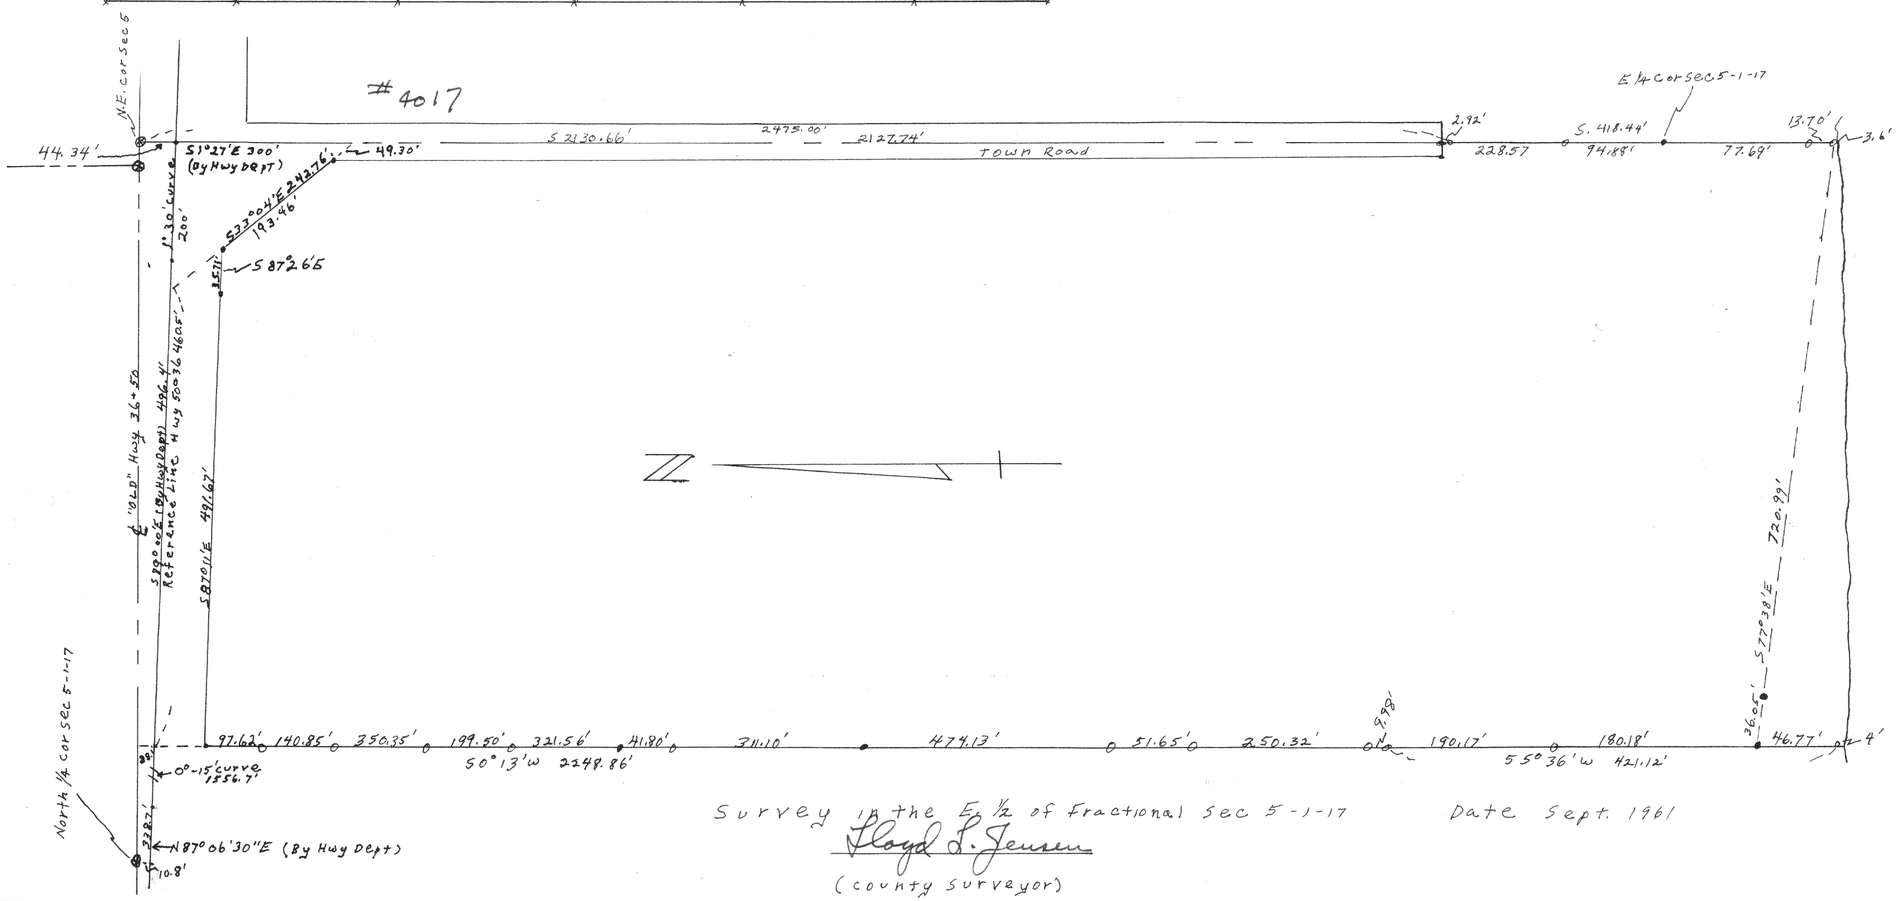

Survey in the E 1/2 of Fractional Sec 5-1-17 Date Sept. 1961
Floyd L. Jensen
(county surveyor)