

#4021

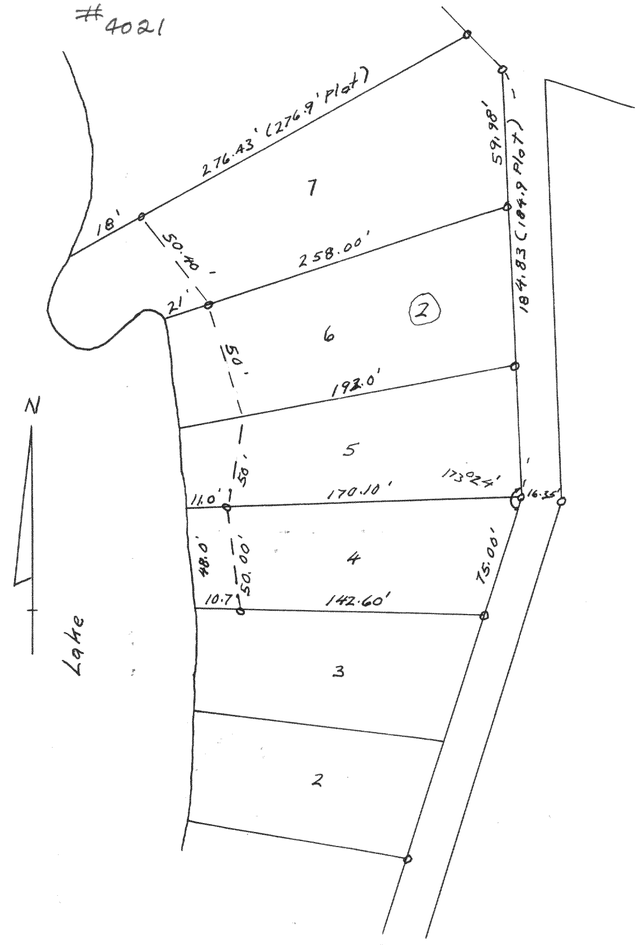

Survey of Lots 4 & 7 Block 2
Swift Lake Subd, T4N, R17E
Date 7-14-61 Floyd L Jensen
(County Surveyor)

#4022

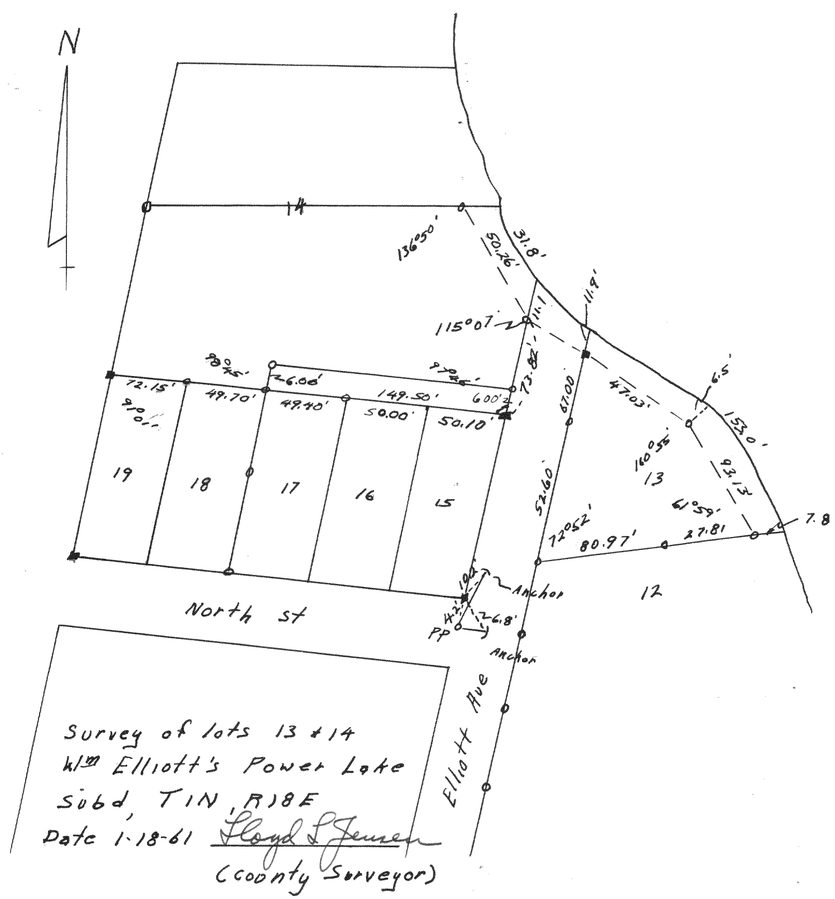

Survey of lots 13 & 14
Wm Elliott's Power Lake
Subd, T1N, R18E
Date 1-18-61 Floyd L Jensen
(County Surveyor)