

#4031

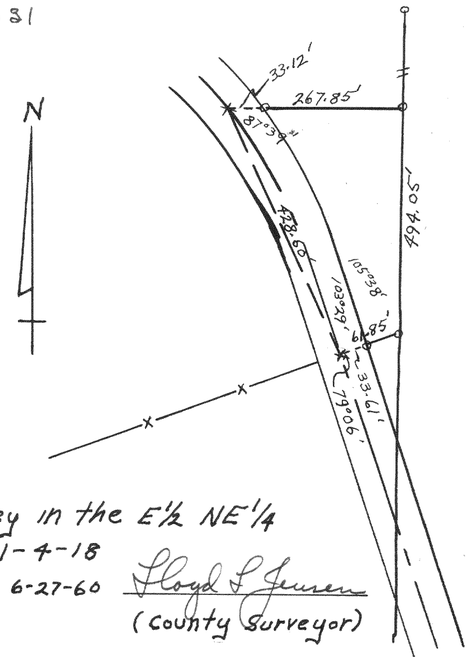


Survey in the E½ NE¼
Sec 1-4-18
Date 6-27-60 Floyd L Jensen
(County Surveyor)

#4032

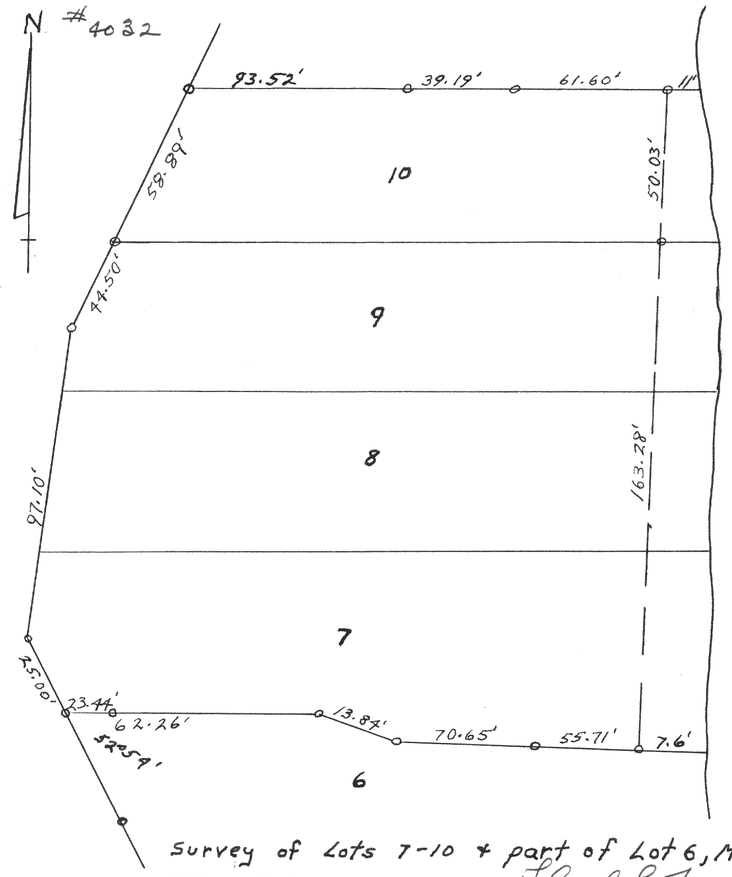

Survey of Lots 7-10 & part of Lot 6, Millsite Subd.
T4N, R18E.
Date 8-23-61 Floyd L. Jensen
(County Surveyor)

#4033

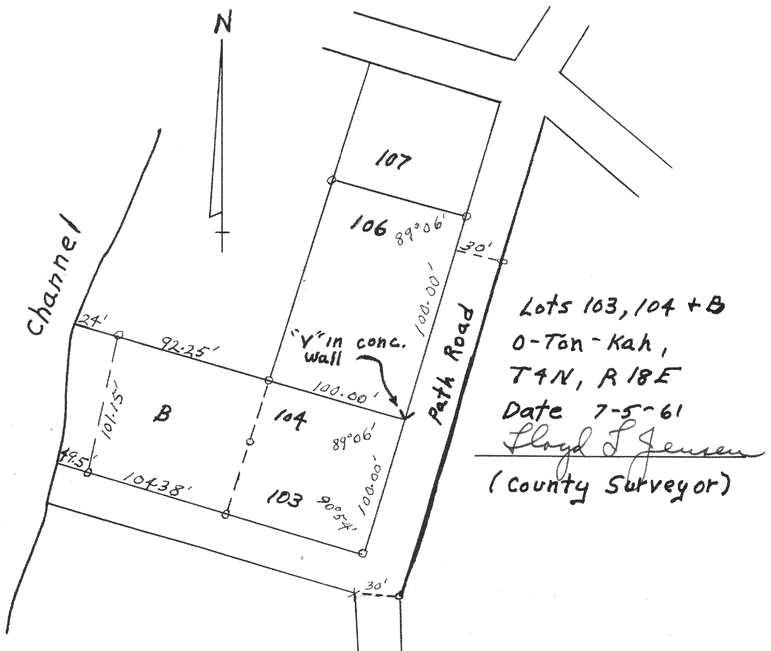

Lots 103, 104 + B
O-Ton-Kah,
T4N, R18E
Date 7-5-61
Floyd L Jensen
(County Surveyor)