

2742

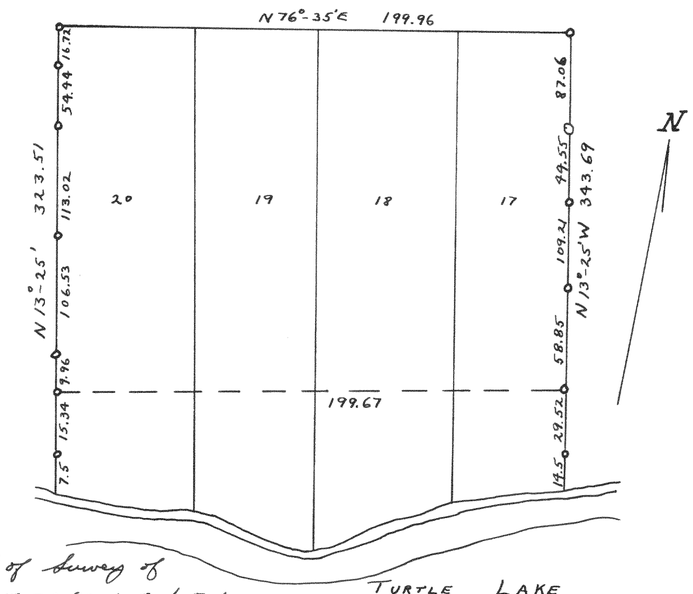

Plat of Survey of
Lots 17-20 (Incl) Oak Park
Sub of Turtle Lake
T3N R15E
Sept 1953 LLJ CS

2743

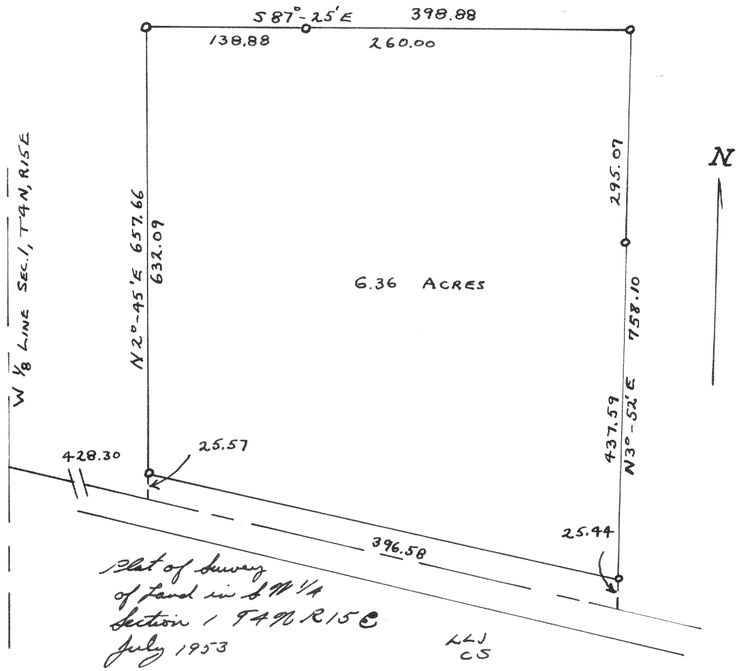

Plat of Survey
of Land in SW 1/4
Section 1 T4N R15E
July 1953 LLJ CS


2744




2746

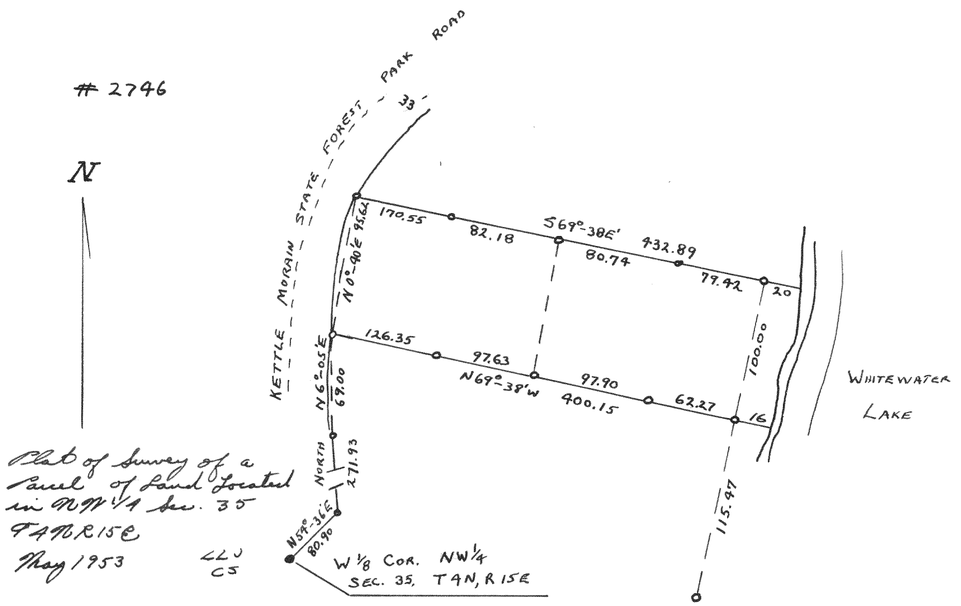

Plat of Survey of a
Parcel of Land Located
in NW 1/4 Sec. 35
T4N R15E
May 1953 LLJ CS