

#4034

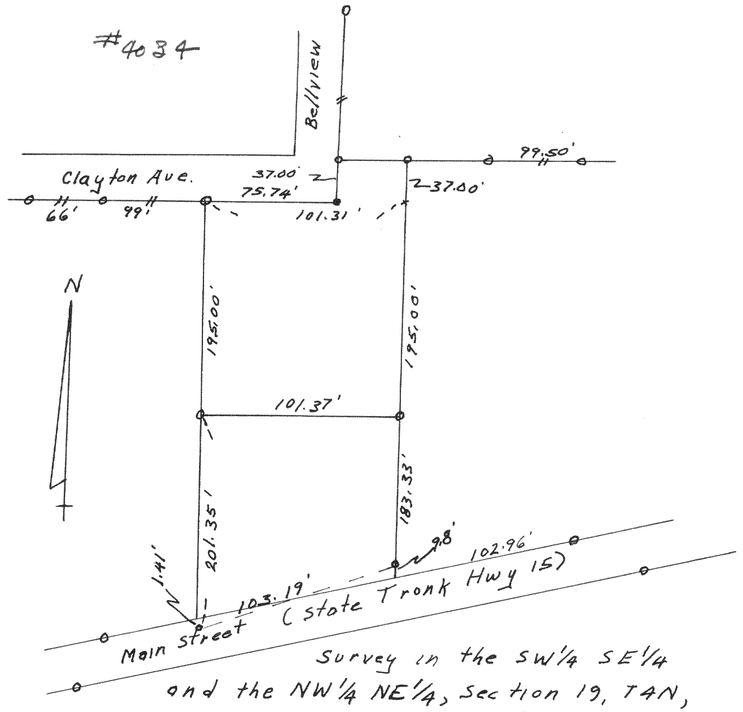


Survey in the SW1/4 SE1/4 and the NW1/4 NE1/4, Section 19, T4N, R18E Village of East Troy
Date 2-13-61 Floyd L Jensen
(County Surveyor)

#4035

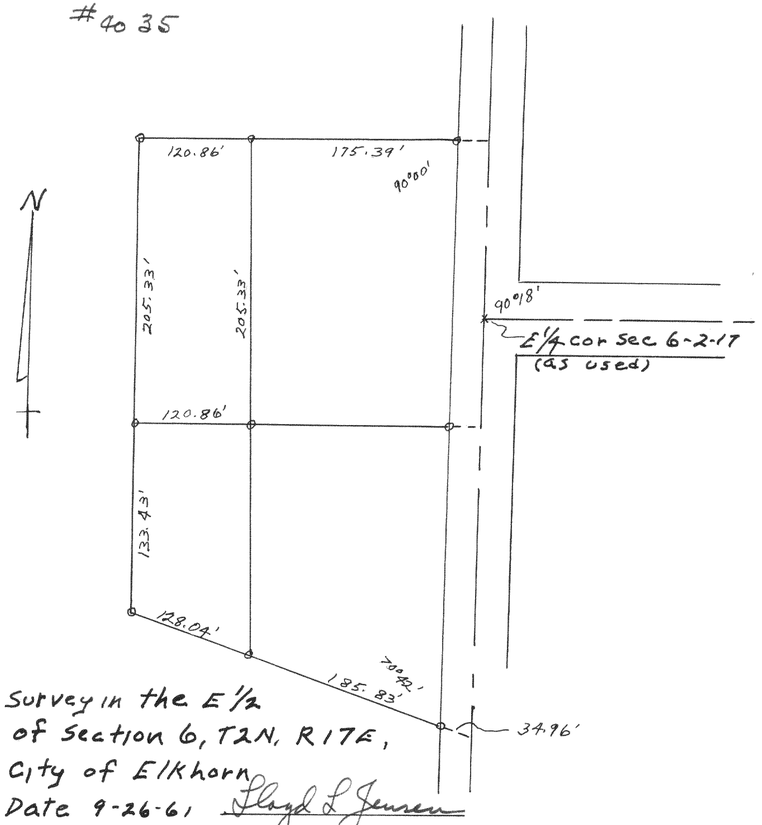


Survey in the E1/2 of Section 6, T2N, R17E, City of Elkhorn
Date 9-26-61 Floyd L Jensen
(County Surveyor)

#4036

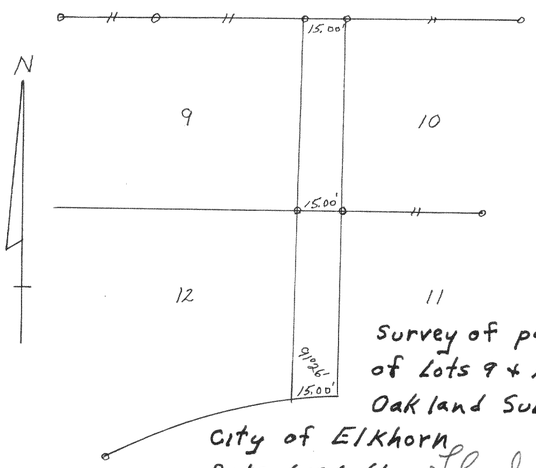

Survey of part of Lots 9 & 12, Oakland Subd, City of Elkhorn
Date 6-24-61 Floyd L Jensen
(County Surveyors)

#4037

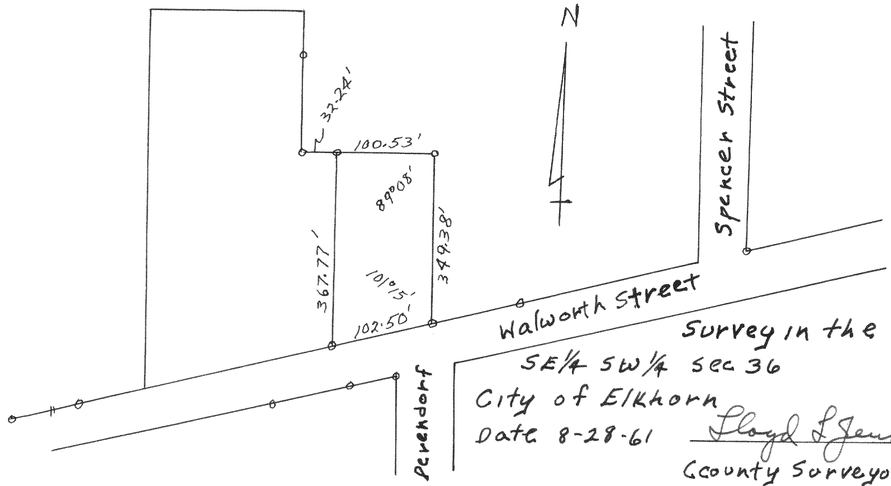

Survey in the SE1/4 SW1/4 Sec 36 City of Elkhorn
Date 8-28-61 Floyd L Jensen
(County Surveyor)