




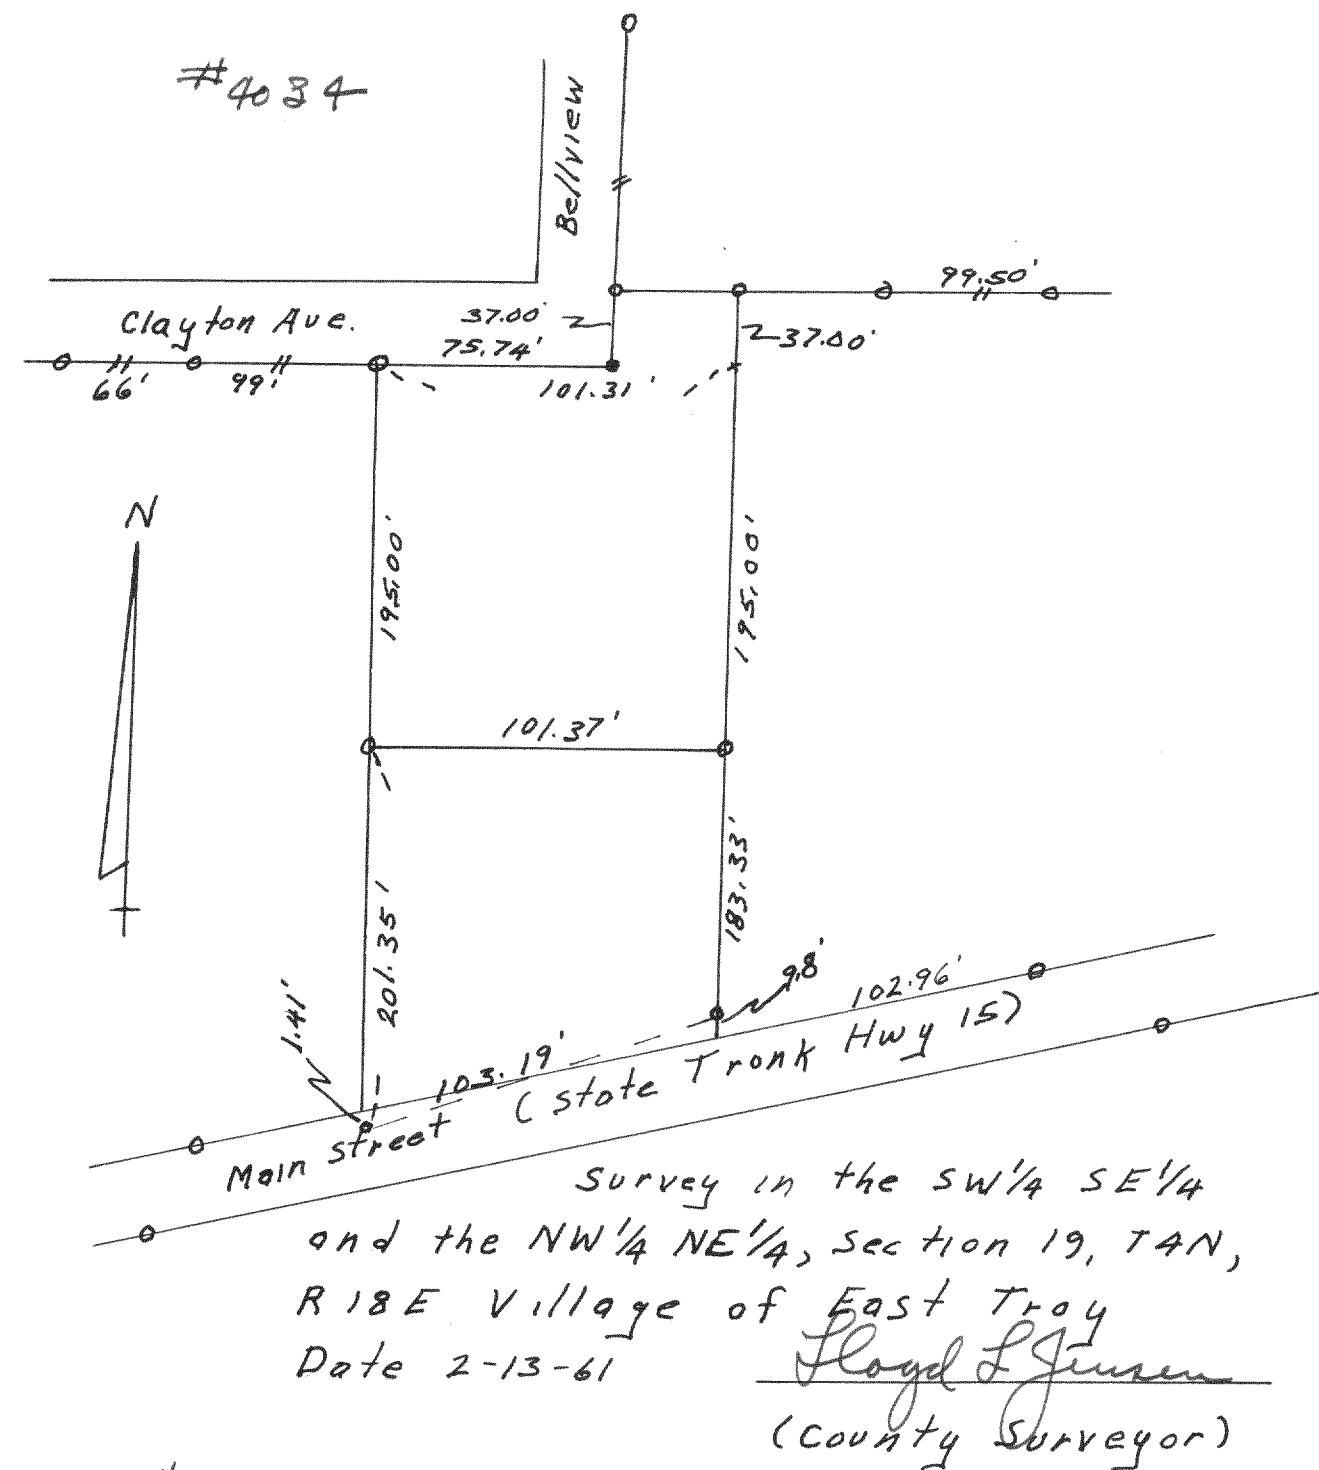

#4036

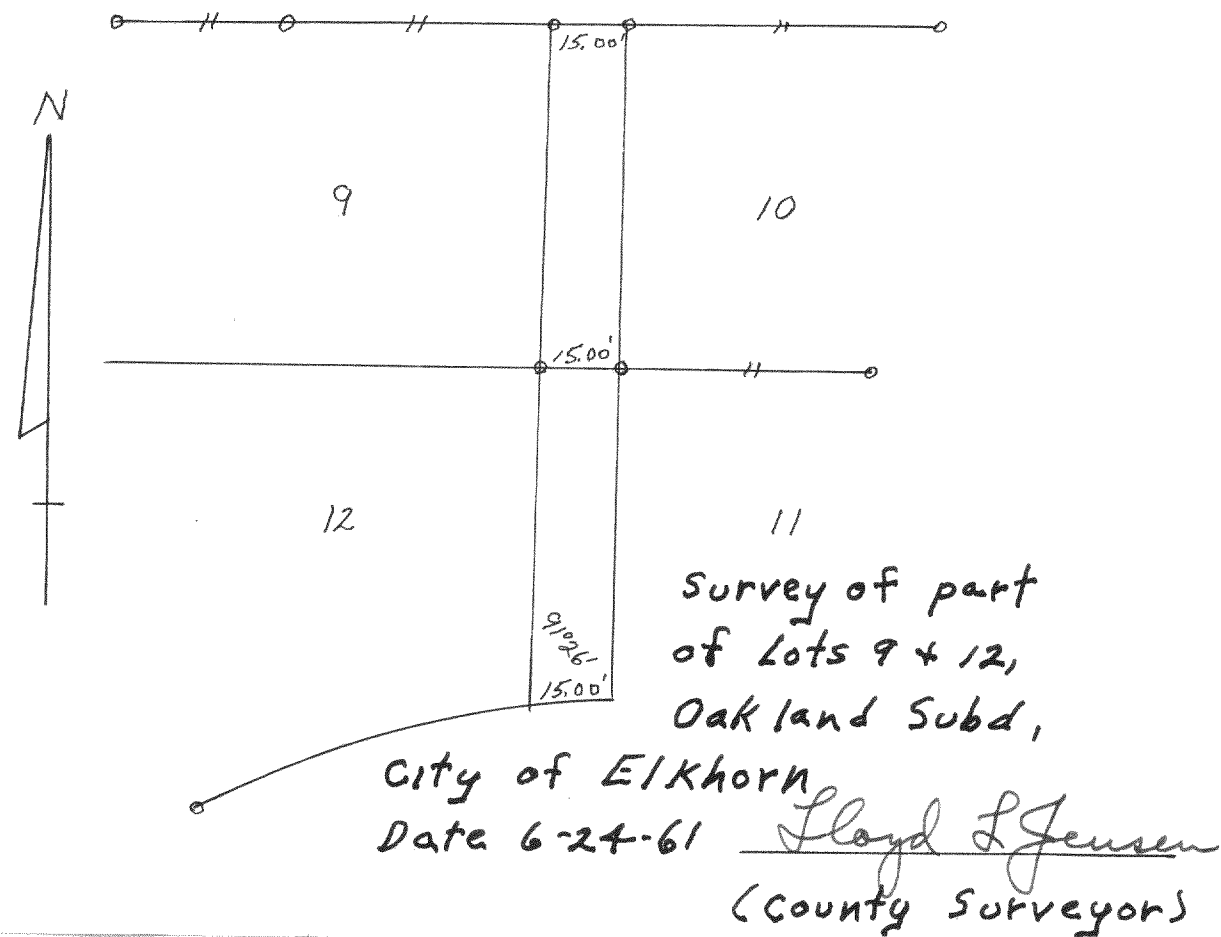

#4035

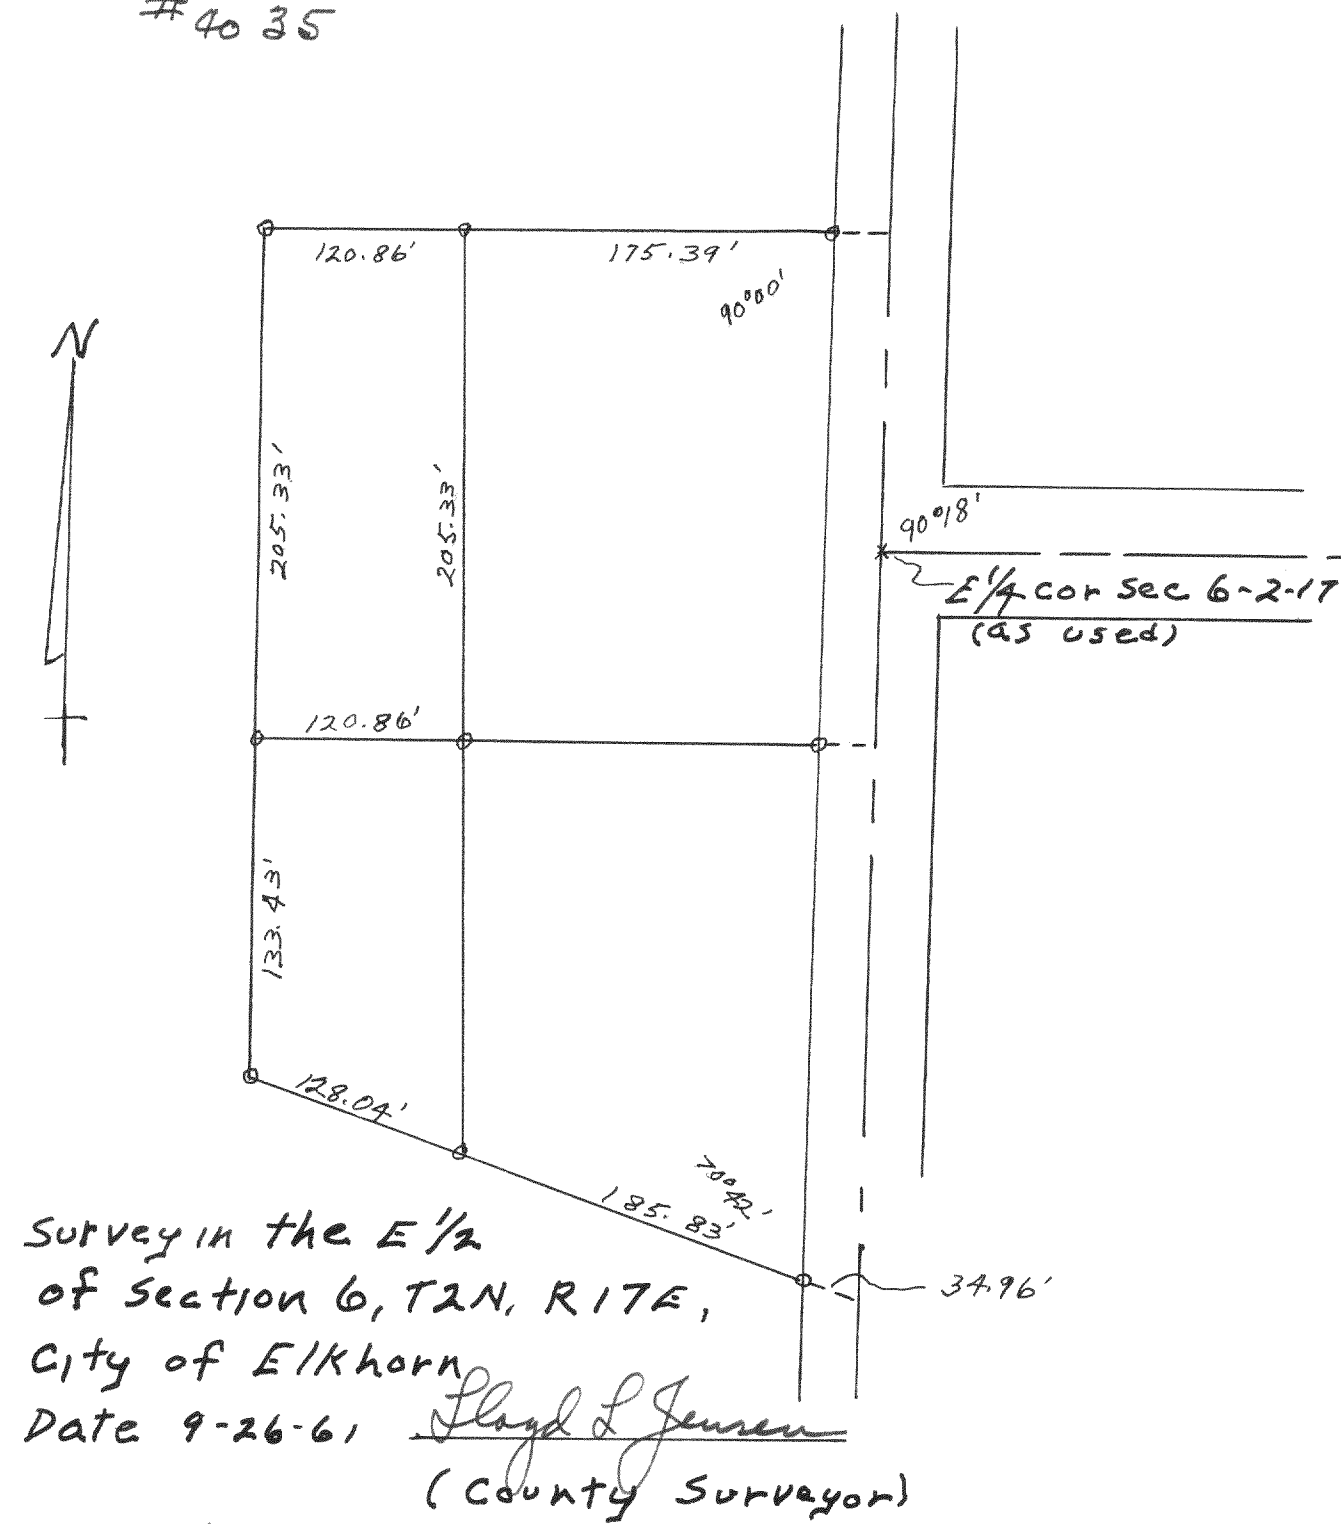

#4037

