

#4038

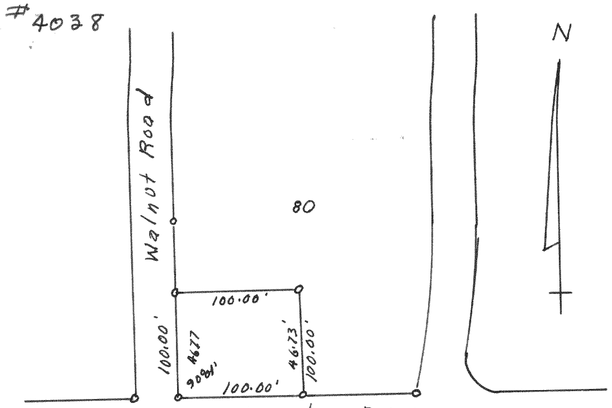

Survey of Lots 4673-77, Block 80, Lake Como Beach, T2N, R17E
Date 9-14-61 Lloyd L Jensen (County Surveyor)

#4039

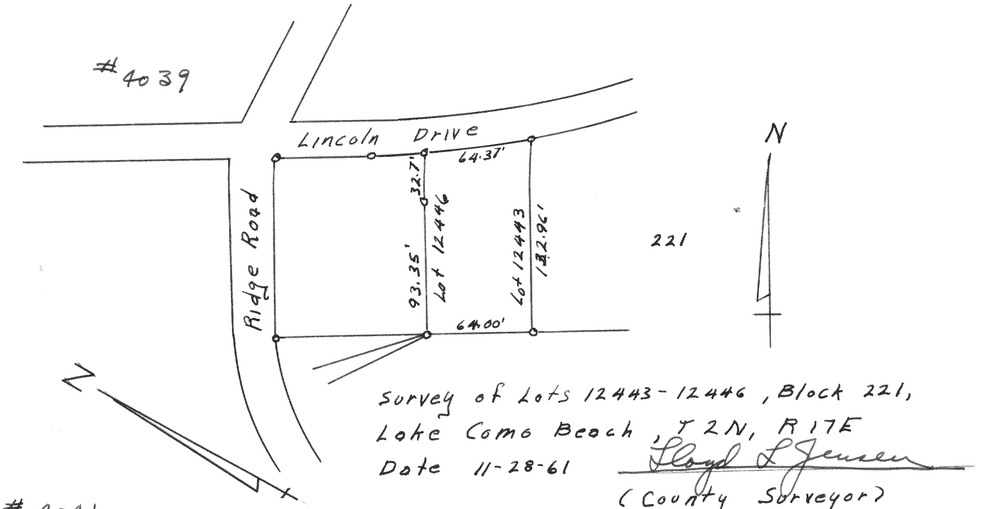


Survey of Lots 12443-12446, Block 221,
Lake Como Beach, T2N, R17E
Date 11-28-61 Lloyd L Jensen
(County Surveyor)


#4041

Town Road

#4040

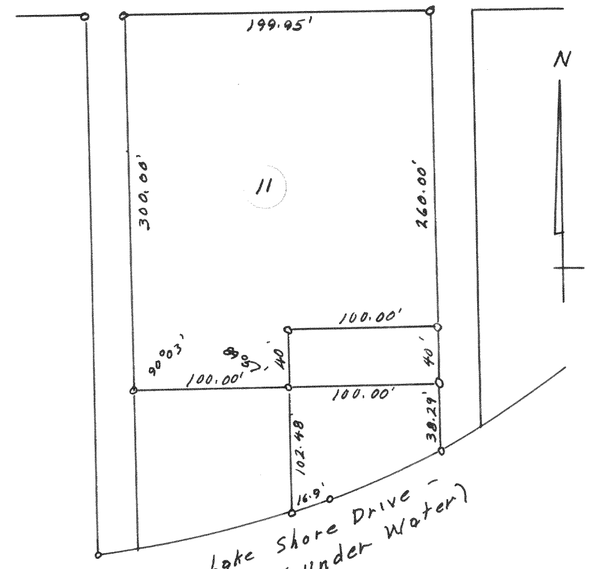

Survey in Block 11, Lake Como Beach, T2N, R17E
Date 9-27-61 Lloyd L Jensen
(County Surveyor)

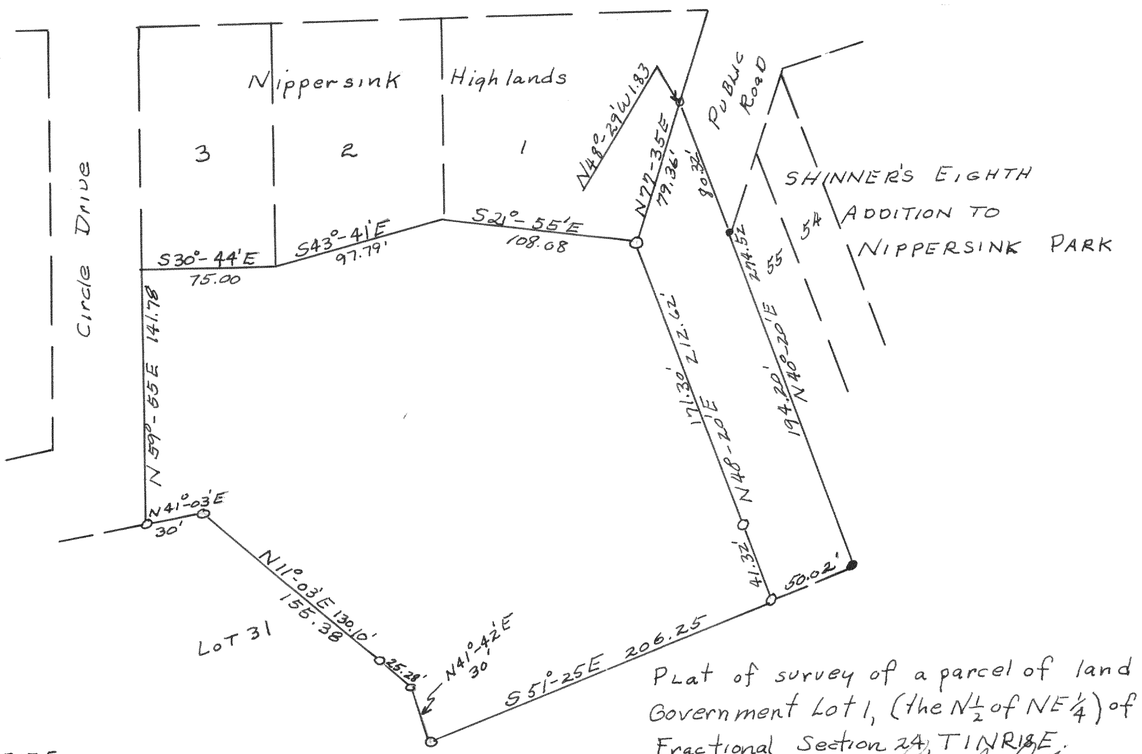

Plat of survey of a parcel of land in Government Lot 1, (the N½ of NE¼) of Fractional Section 24, T1NR8E.
Feb. 1962 Lloyd L Jensen
County Surveyor