
#4043

PLAT OF SURVEY OF

Part of Lot 27, Millsite Subdivision
located in the Northwest 1/4 of Section 4,
T4N, R18E, Walworth County, WISCONSIN

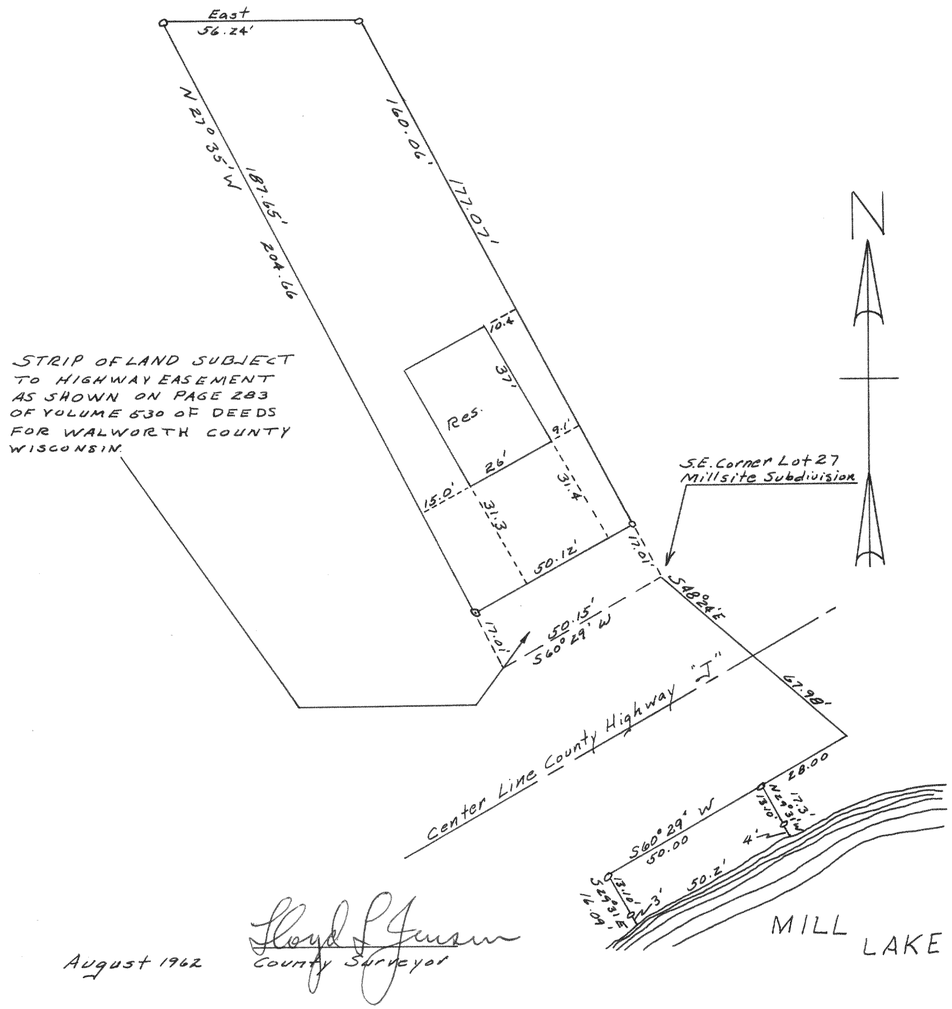


August 1962

Floyd L. Jensen
County Surveyor

#4044

PLAT OF SURVEY OF

Lots 4251 to 4255 of Section 3 of
Pell Lake Subdivision, Walworth County,
WISCONSIN

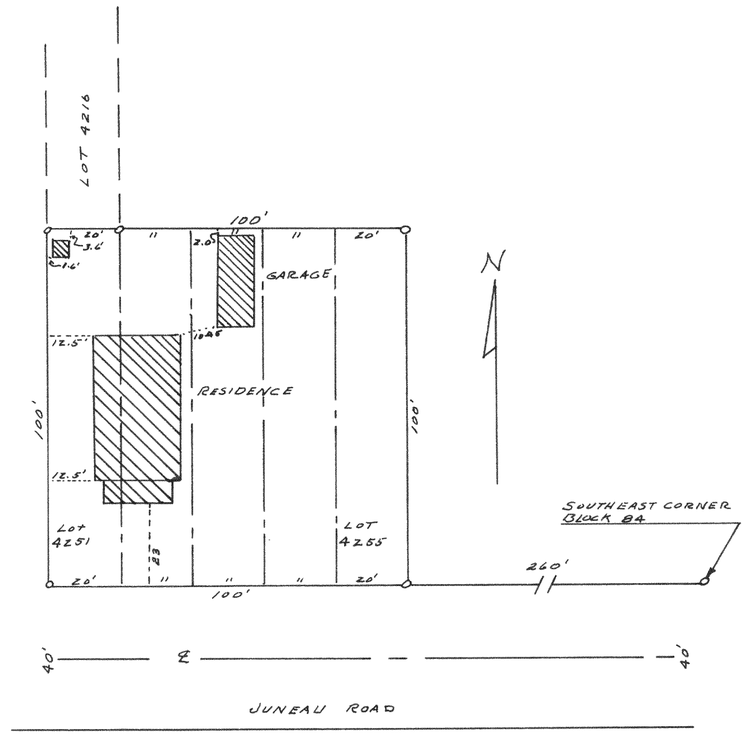

August 1962

Floyd L. Jensen
County Surveyor