
4048


Plat of survey of Land
Located in the NW¼ of
Section 5, T4N R15E
City of Whitewater, Wis.

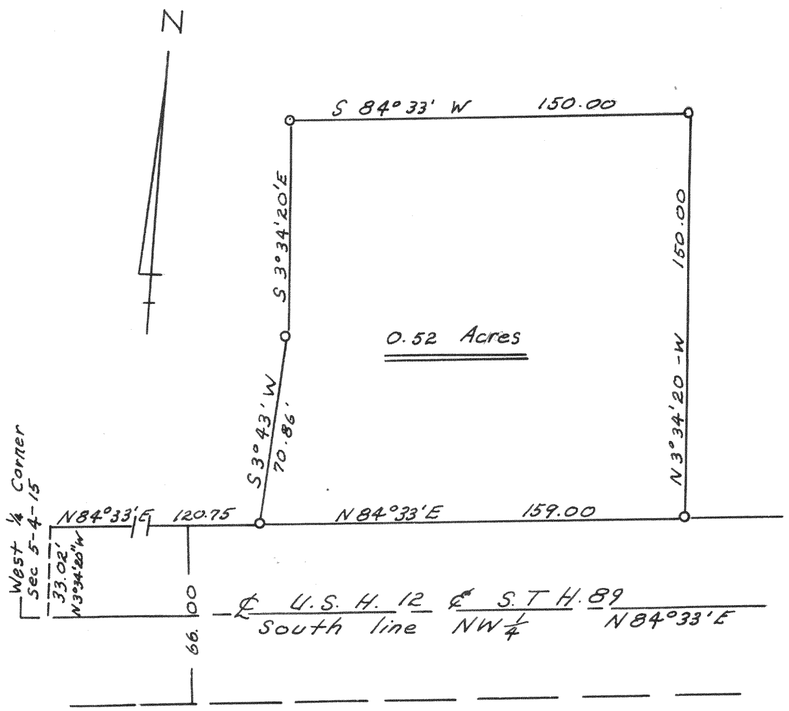

Floyd L Jensen
(County Surveyor) November 9, 1962

4049

PLAT OF SURVEY OF
Lots 14 & 15, Block 1,
Shinner's 8th Addition to
Nippersink Park
T1N, R18E, Walworth County
Wisconsin.

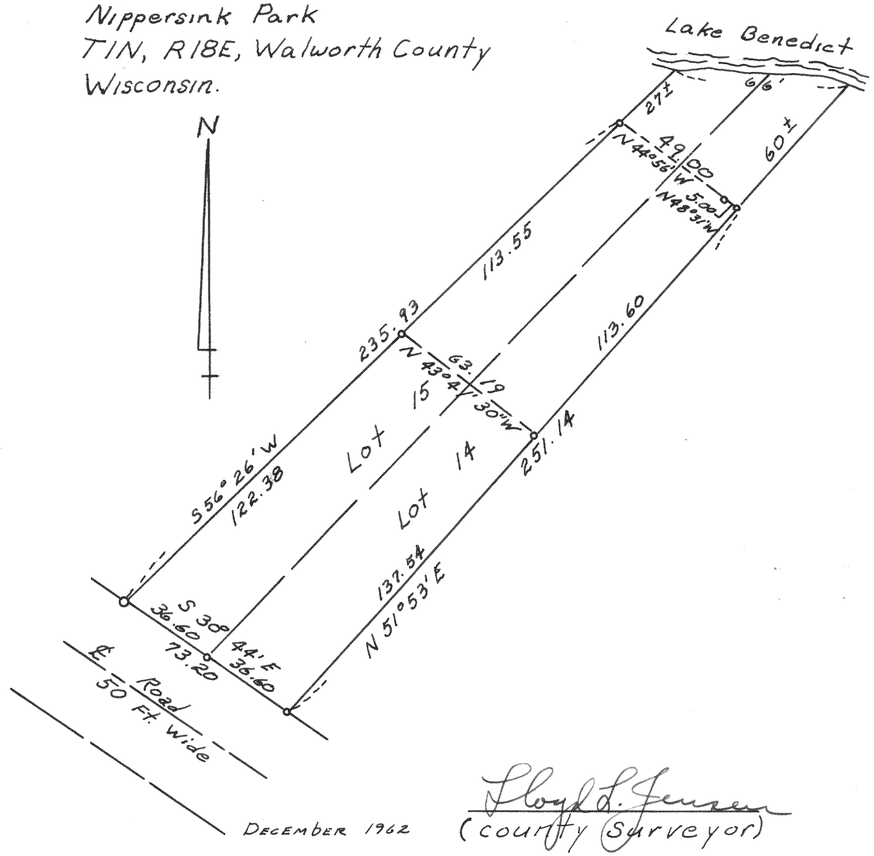

DECEMBER 1962

Floyd L. Jensen
(County Surveyor)