
328

#4055


PLAT OF SURVEY OF
LOT NUMBERED FOUR (4) OF INDIAN ECHO ESTATES, A PROPOSED SUBDIVISION LOCATED IN THE NORTH WEST 1/4 OF THE NORTHEAST 1/4 OF SECTION 34, T2N, R 17 E, WALWORTH COUNTY, WISCONSIN.

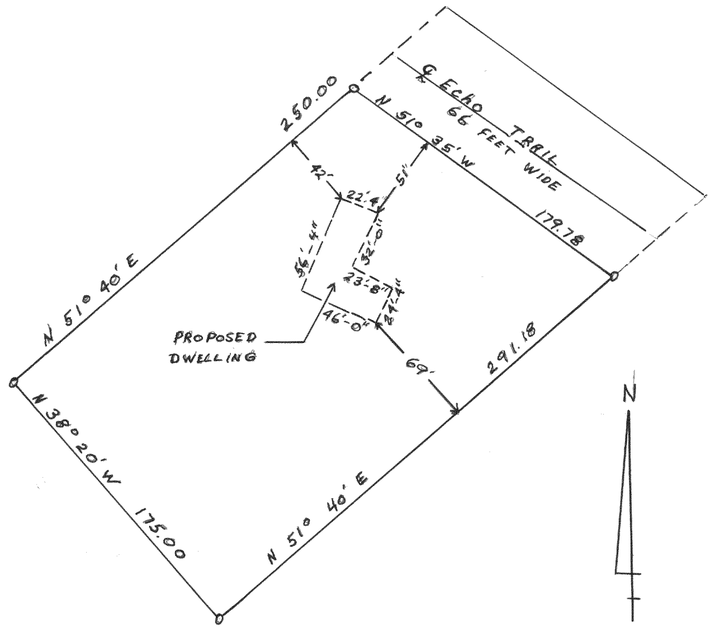

APR. 1963 Floyd L Jensen
WAL CO. SURVEYOR

#4056

PLAT OF SURVEY OF
LOT 11 - BLOCK 2
UNIVERSITY HEIGHTS
VILLAGE OF WILLIAMS BAY
WALWORTH COUNTY, WISCONSIN

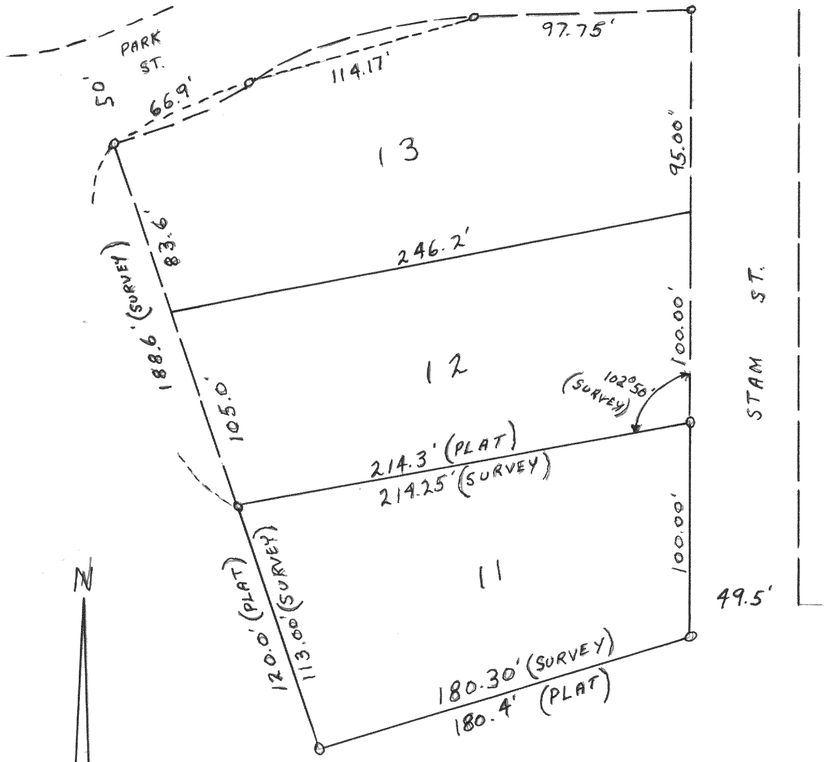

FEB. 1963 Floyd L Jensen
WAL. CO. SURVEYOR