
#4057


PLAT OF SURVEY OF
Lot 9
Lynndale Subdivision SE¼ NW¼ & SW¼ NW¼ Sec 20, T4N RIBE VILLAGE OF EAST TROY WALWORTH COUNTY, WISCONSIN

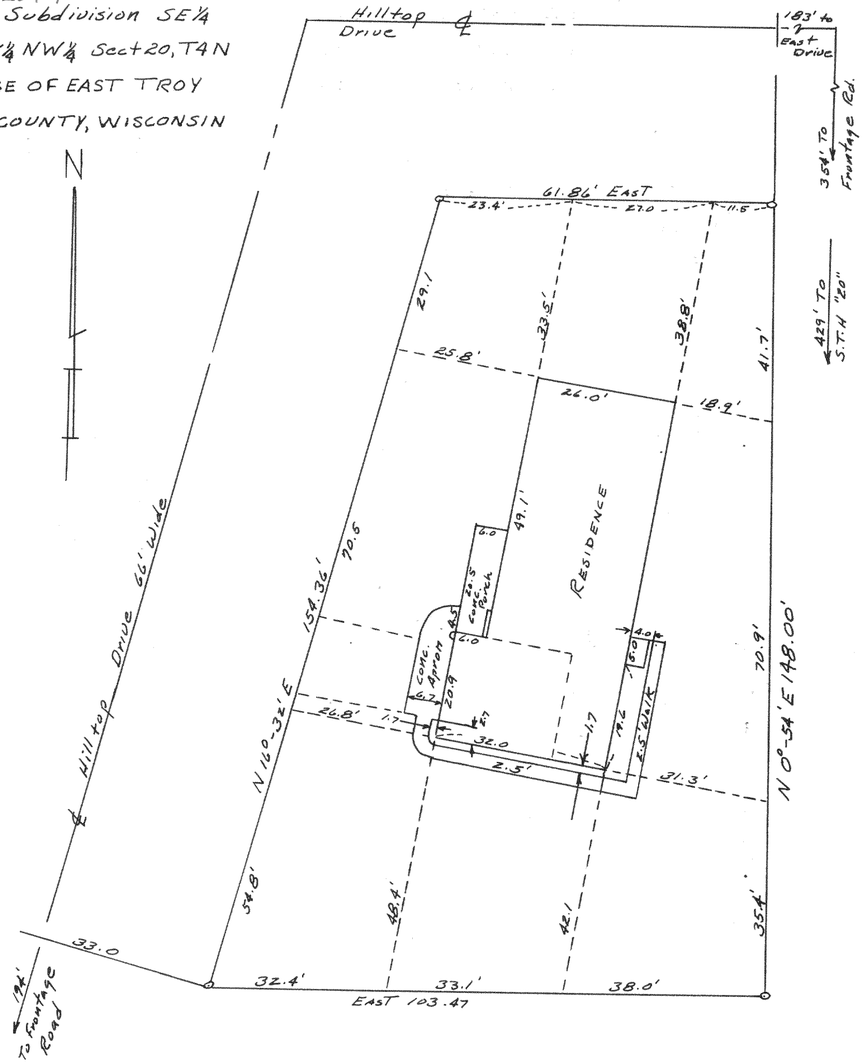

September 26, 1962 — Floyd L Jensen, County Surveyor

#4058

PLATE OF SURVEY OF
Lands located in the SW¼ of Section 5, T4N-R15E Walworth County, Wisconsin

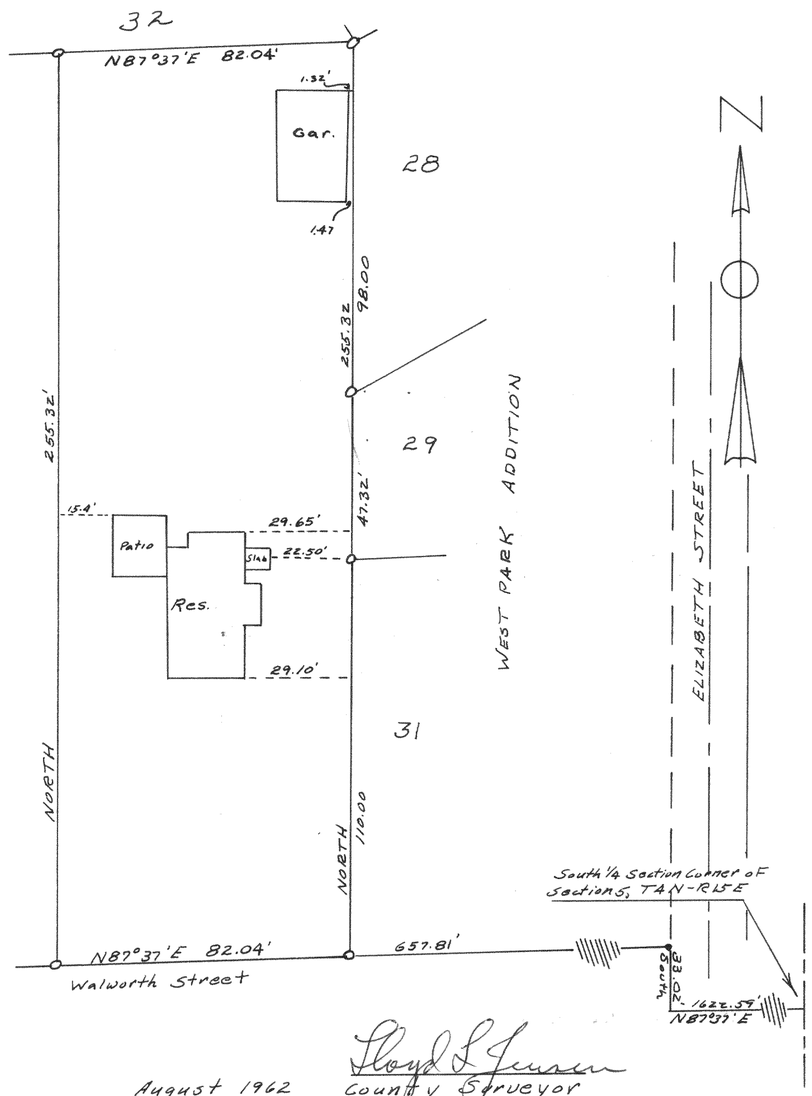

August 1962 — Floyd L Jensen, County Surveyor