
4059

PLAT OF SURVEY OF

ALL THAT PART OF THE SE 1/4 OF SECTION 19 AND THE NE 1/4 OF SECTION 30, T 4 N, R 18 E, WALWORTH COUNTY, WISCONSIN BOUNDED AND DESCRIBED AS FOLLOWS, TO-WIT:

COMMENCING AT THE INTERSECTION OF THE NORTH LINE OF MAIN STREET AND THE EAST LINE OF BEULAH AVENUE IN THE VILLAGE OF EAST TROY, THENCE N 00° 45" W IN THE EAST LINE OF SAID BEULAH AVENUE 133.60 FEET; THENCE N 89° 45" E 74.25 FEET; THENCE S 00° 47' E 121.84 FEET; THENCE S 81° 00' W ALONG THE NORTH LINE OF MAIN STREET 75.18 FEET TO THE POINT OF BEGINNING

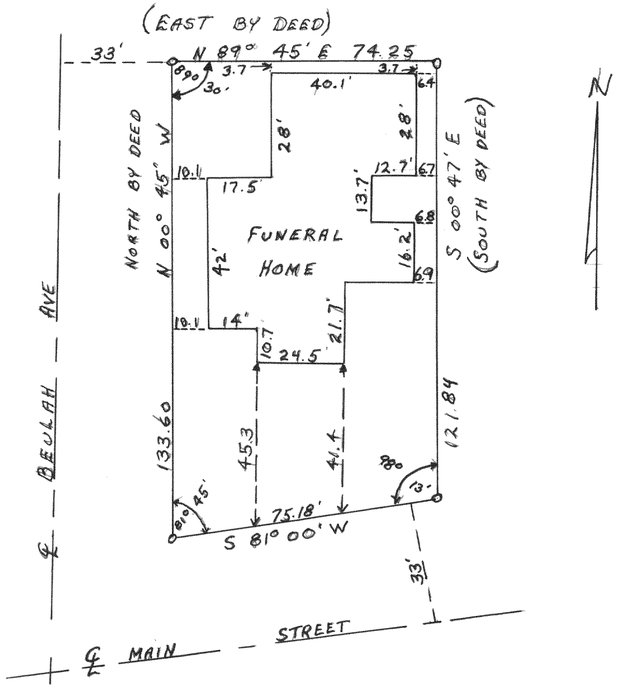


MARCH 1963 Floyd L Jensen
WAL. CO. SURVEYOR

4060

PLAT OF SURVEY OF

ALL THAT PART OF LOTS 4, 5, 8, OF BLOCK 2 OF THE ORIGINAL PLAT TO THE CITY OF LAKE GENEVA WALWORTH COUNTY, WISCONSIN BOUNDED AND DESCRIBED AS FOLLOWS, TO-WIT;

BEGINNING AT THE NORTHEAST CORNER OF SAID LOT 4 AND RUNNING THENCE SOUTH ALONG THE EAST LINE OF SAID BLOCK 2, 159.50 FEET, THENCE WEST PARALLEL TO THE NORTH LINE OF SAID LOT 4 134.00 FEET; THENCE NORTH PARALLEL TO THE EAST LINE OF SAID BLOCK 2, 84.50 FEET; THENCE EAST PARALLEL TO THE NORTH LINE OF SAID LOT 4, 34.00 FEET; THENCE NORTH PARALLEL TO THE EAST LINE OF SAID BLOCK 2, 75.00 FEET TO THE NORTH LINE OF SAID LOT 4; THENCE EAST ALONG THE NORTH LINE OF SAID LOT 4, 100.00 FEET TO THE POINT OF BEGINNING, CONTAINING 18,820 SQUARE FEET OF LAND MORE OR LESS.

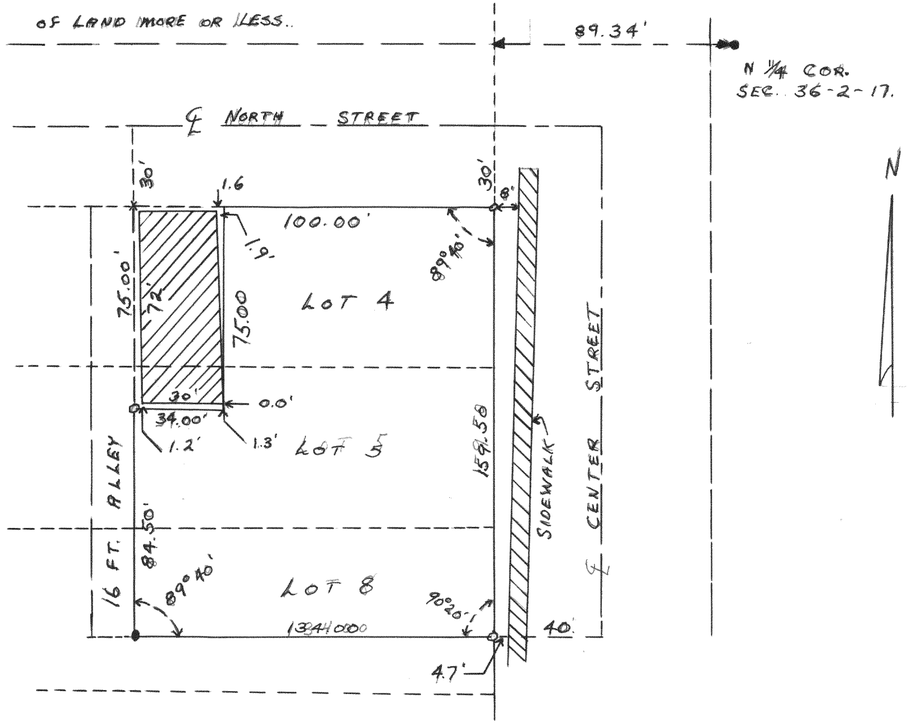

MARCH 1963 Floyd L Jensen
WAL. CO. SURVEYOR