
4074


PLAT OF SURVEY OF
Lot 26, BLOCK 18, DELAVAN LAKE
View Crest, T2N R 16E
WALWORTH COUNTY, WISCONSIN

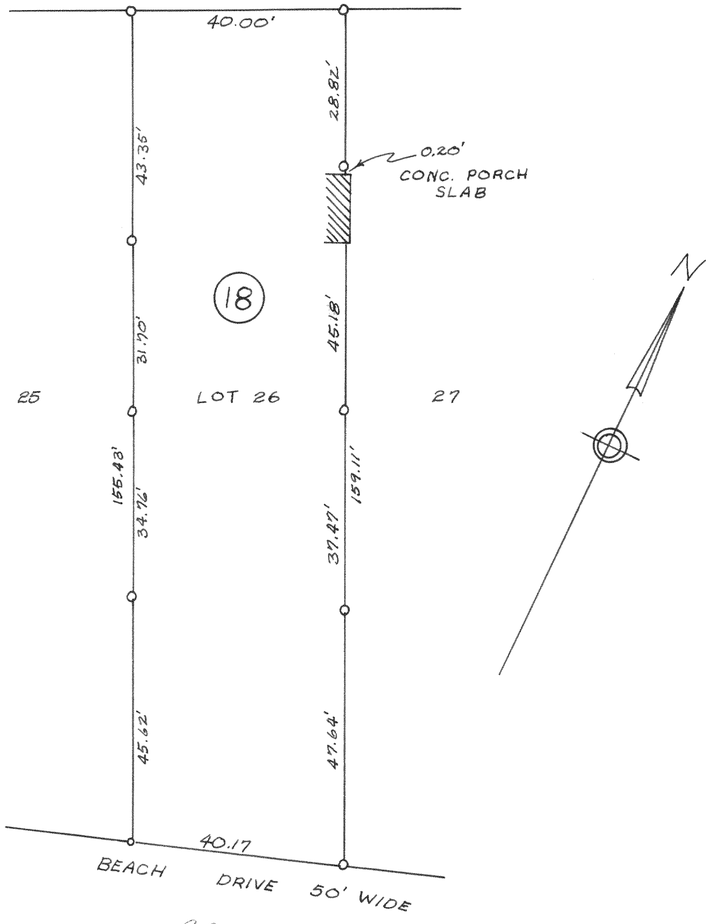

Sept 1962 Floyd L Jensen Wal. Co Surveyor

4075

PLAT OF SURVEY OF
Lot 5, Chamberlains Subdvision
Located in Northwest ¼ of Section 9,
T4N, R 18E
WALWORTH COUNTY, WISCONSIN

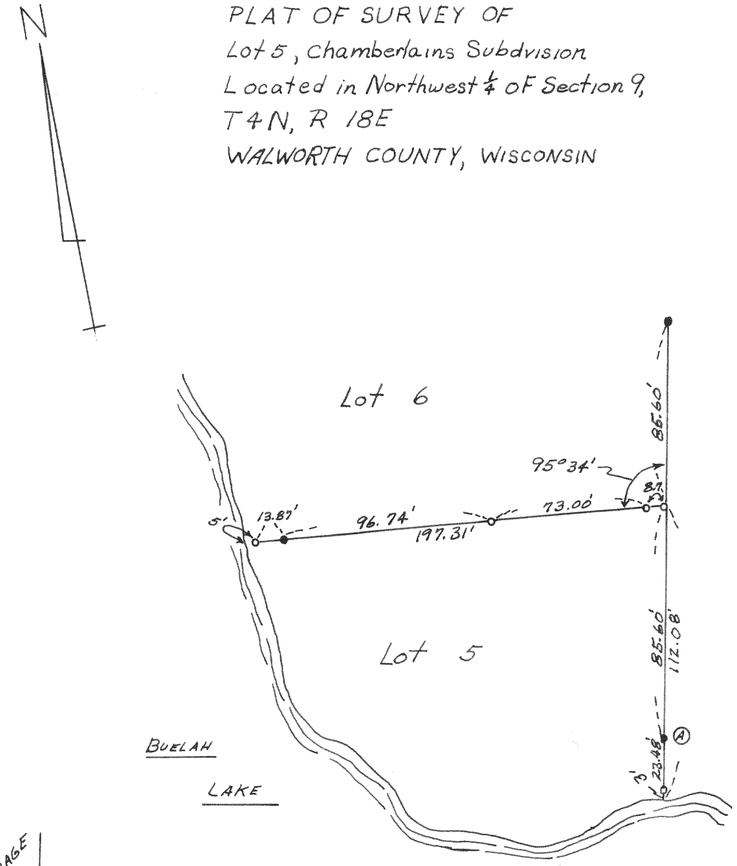

October 1, 1962 Floyd L Jensen Wal. Co. Surveyor