4074

PLAT OF SURVEY OF
Lot 26, BLOCK 18, DELAVAN LAKE
View Crest, T2N R 16E
WALWORTH COUNTY, WISCONSIN

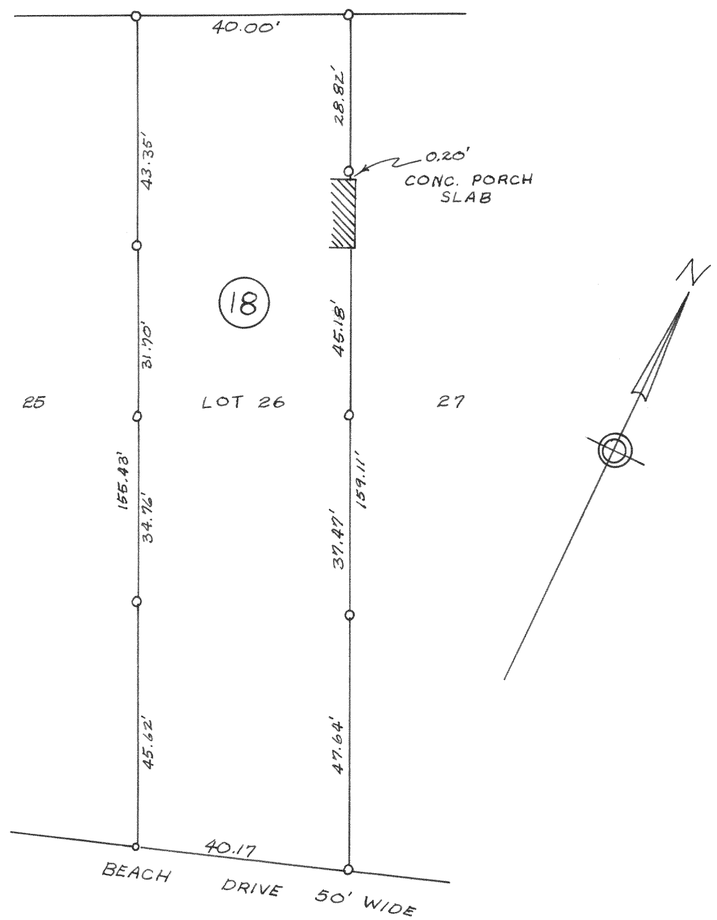

Floyd L Jensen
Sept 1962 Wal. Co Surveyor

4075

PLAT OF SURVEY OF
Lot 5, Chamberlains Subdivision
Located in Northwest ¼ of Section 9,
T4N, R 18E
WALWORTH COUNTY, WISCONSIN

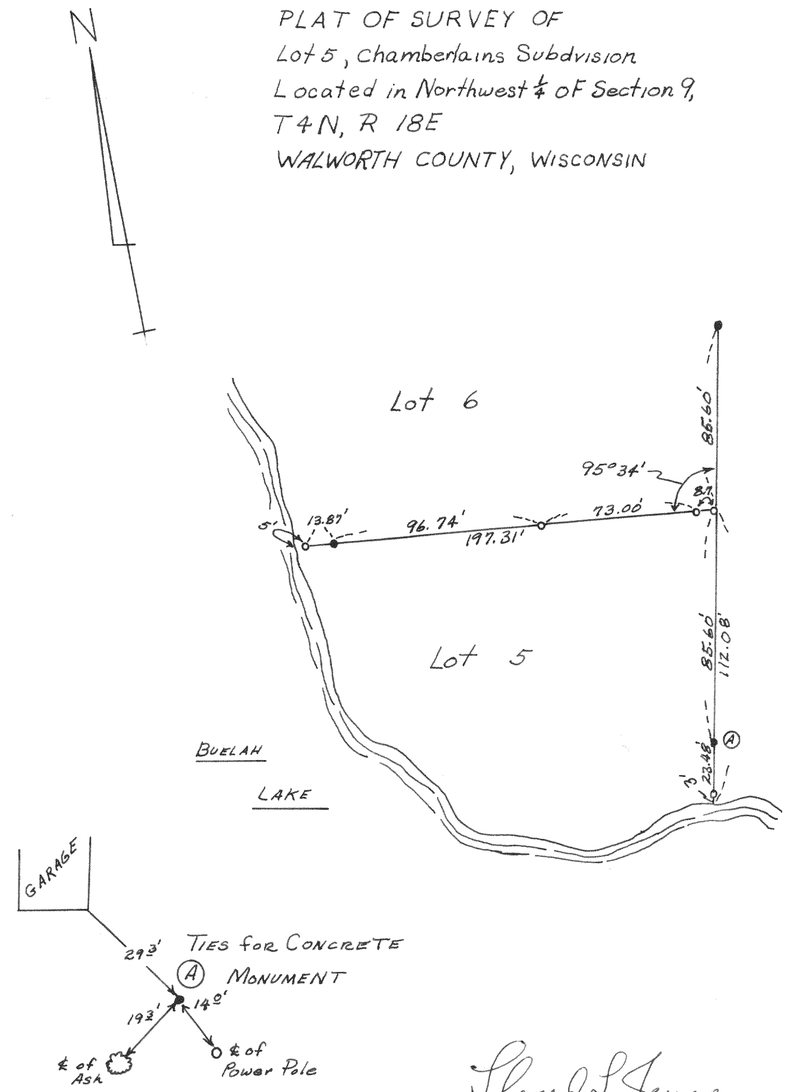

Floyd L Jensen
October 1, 1962 Wal. Co. Surveyor