
#4077

PLAT OF SURVEY OF

Lot 27 of the subdivision of block 6 of Indian Hills Subdivision, Fontana-on-Geneva Lake, Walworth County, Wisconsin

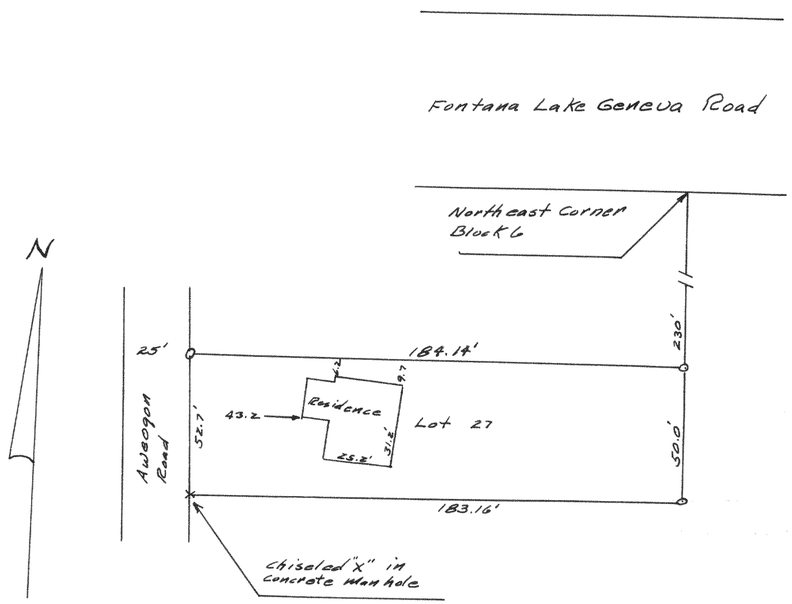


August 1962 — Floyd L Jensen, County Surveyor

#4078

PLAT OF SURVEY OF

Lots 4221 to 4216 of Section 3 of Pell Lake Subdivision, Walworth County, Wisconsin.

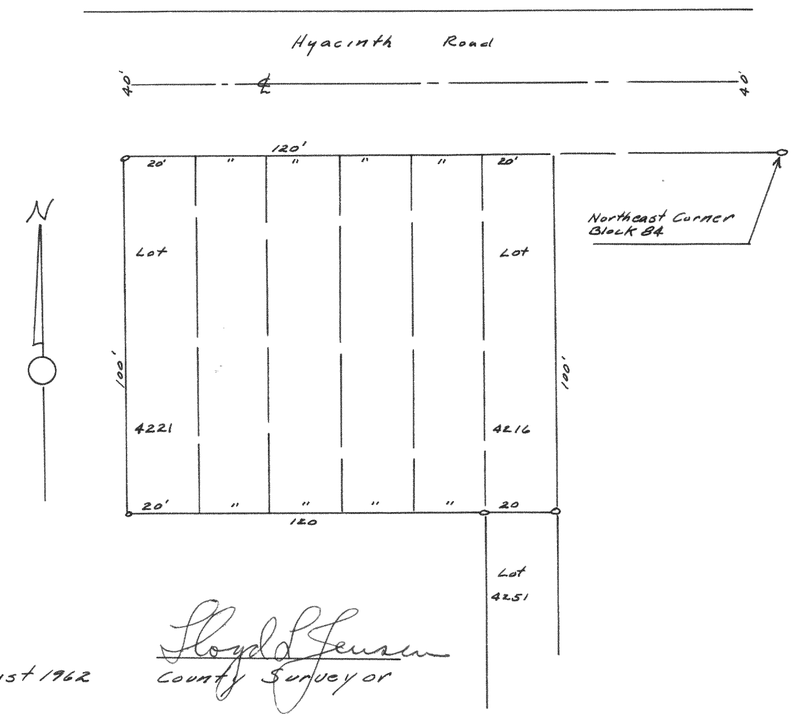

August 1962 — Floyd L Jensen, County Surveyor