
#4083

PLAT OF SURVEY OF
LOT 63 WEST PARK SECOND ADDITION
IN THE SW¼ OF SECTION 5, T4N, R15E,
CITY OF WHITEWATER, WALWORTH COUNTY,
WISCONSIN

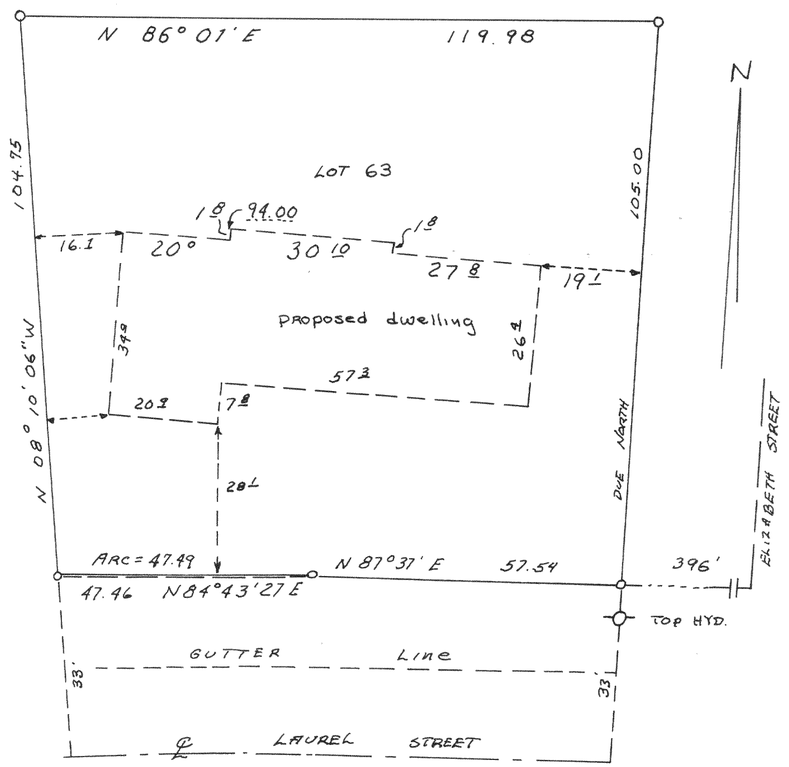


18
May, 1962

Floyd L Jensen
Wah. Co. SURVEYOR

#4084

PLAT OF SURVEY OF
LOTS 10, 11, 12, BLOCK 1, MIRAMAR
SUBDIVISION LOCATED IN SECTION 10 & 11
T4N, R18E WALWORTH COUNTY WISCONSIN

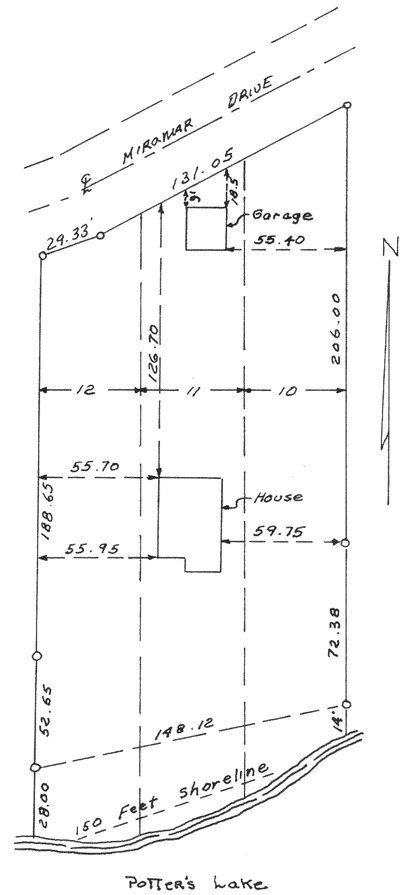

OCT. 1962

Floyd L Jensen
Wah. Co. SURVEYOR