
PLAT OF SURVEY

#4086

OF

Lot 4, Ceylon Court Estates, City of Lake Geneva, Walworth County, Wisconsin

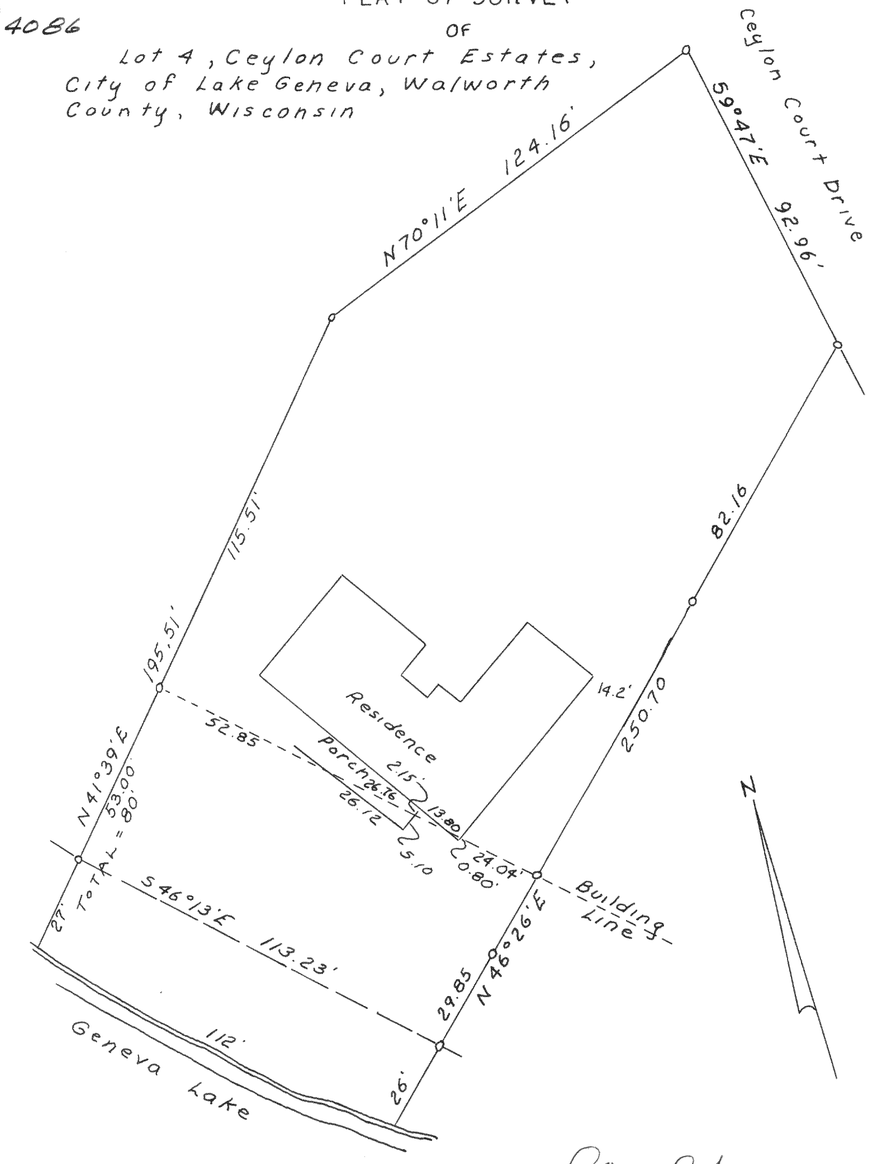

May 1959


Floyd L Jensen

Wal. Co. Surveyor

#4087

Plat of Survey of

Lot 14 in Block 4 of Citizens addition To The Village of Sharon Walworth County, Wisconsin

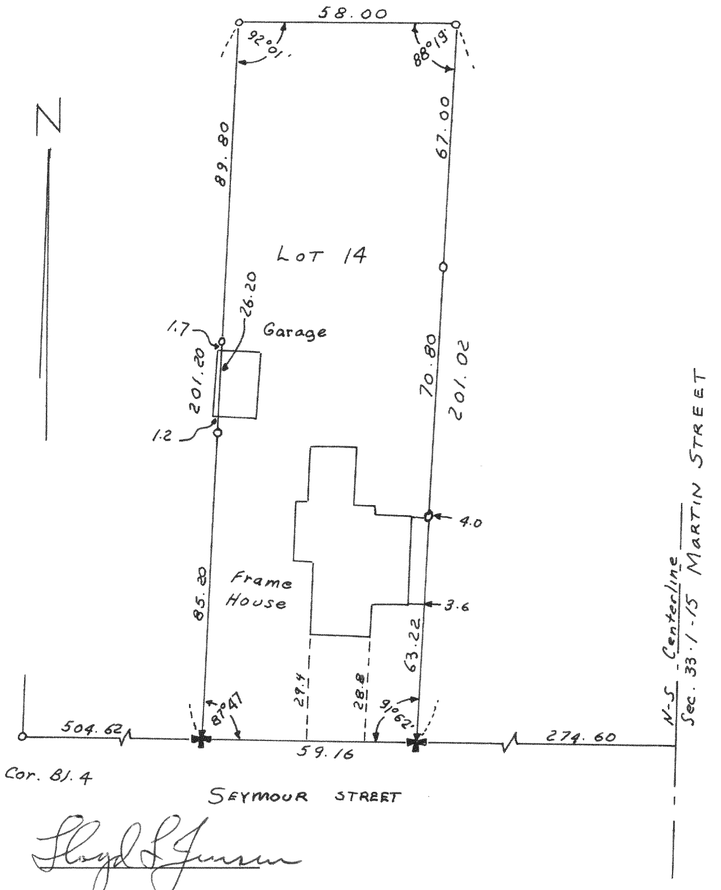

SEPT. 1962

Floyd L Jensen

Wal. Co. SURVEYOR