

2754

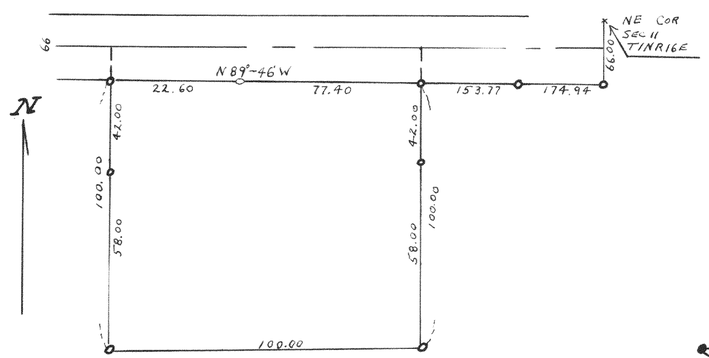


Plat of Survey of land located in NE 1/4 Sec. 11 T1NR16E
Aug., 1953 LLV CS

2755

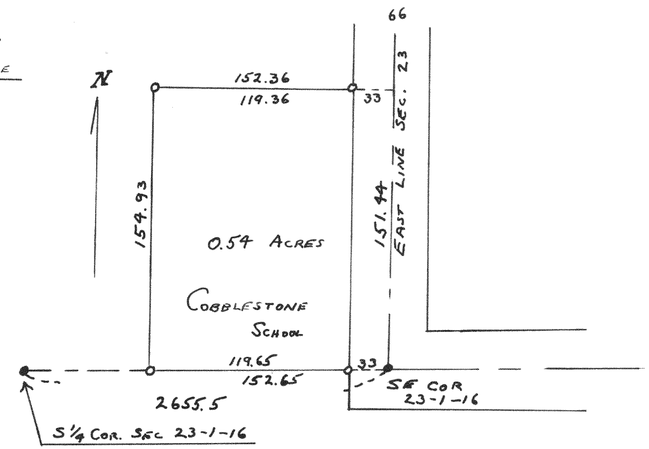


Plat of Survey of Parcel in SE 1/4 of Sec. 23, T1NR16E
July 1953 LLV CS

2756

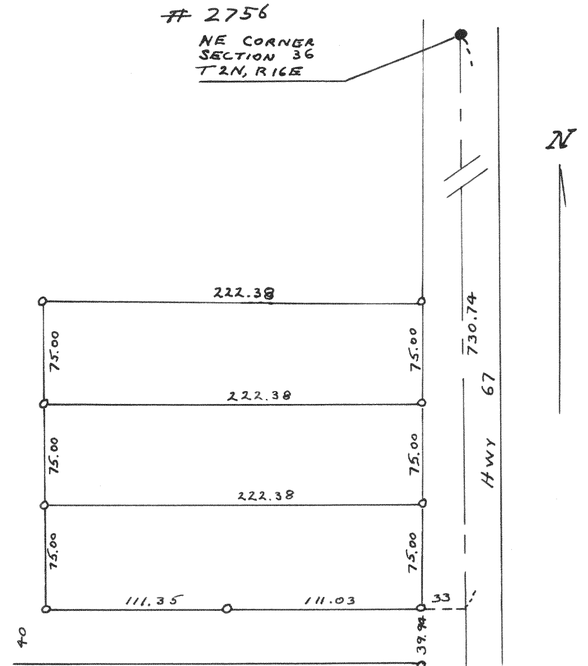


Plat of Survey of Land Located in NE 1/4 of Sec. 36, T2NR16E
Dec, 1953 LLV CS

2757

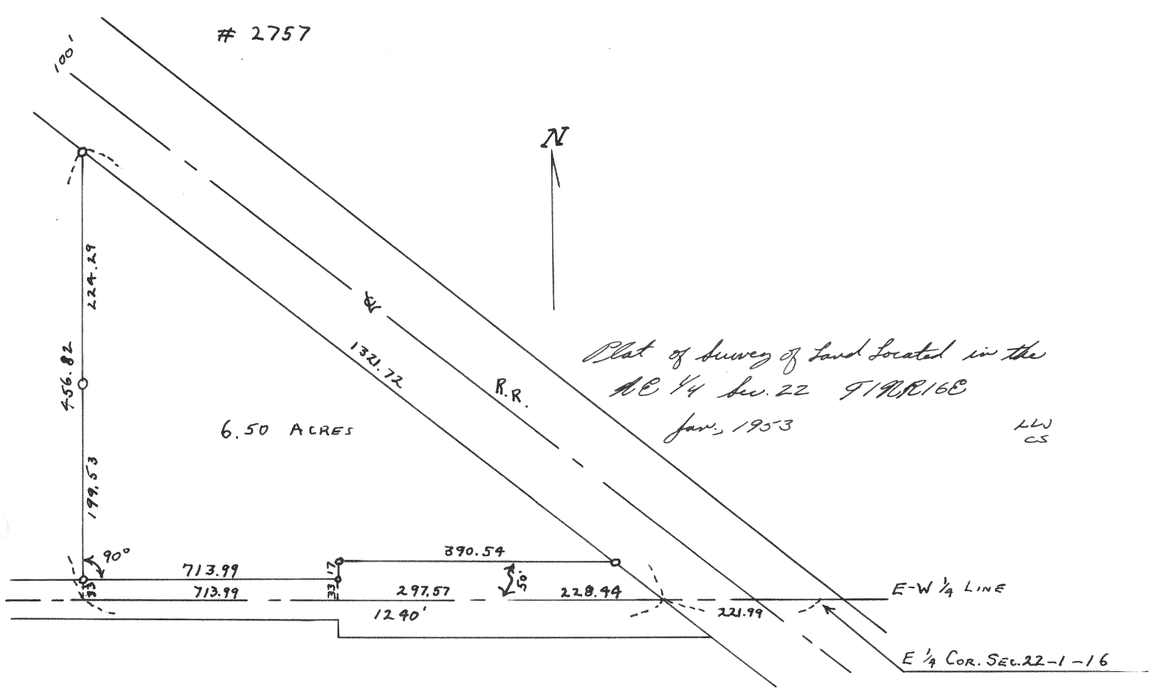

Plat of Survey of Land Located in the NE 1/4 Sec. 22 T1NR16E
Jan., 1953 LLV CS

2758

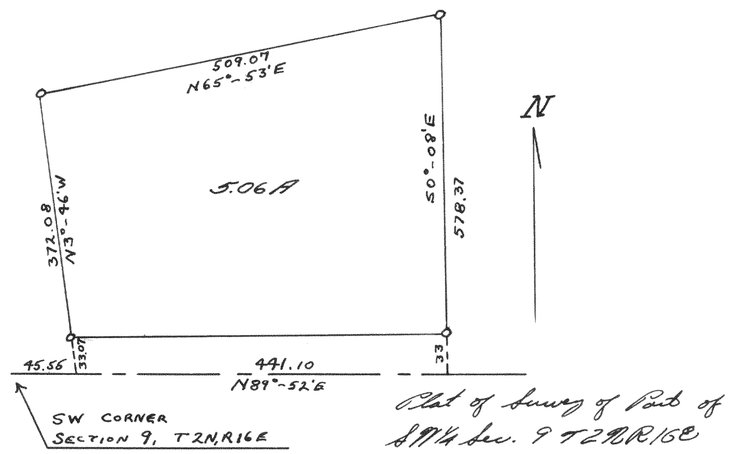

Plat of Survey of Part of SW 1/4 Sec. 9 T2NR16E
May, 1953 LLV CS