
#4093

PLAT OF SURVEY OF
LOT 2 SUNSET HILLS SHORES
T1N, R17E
WALWORTH COUNTY, WISCONSIN

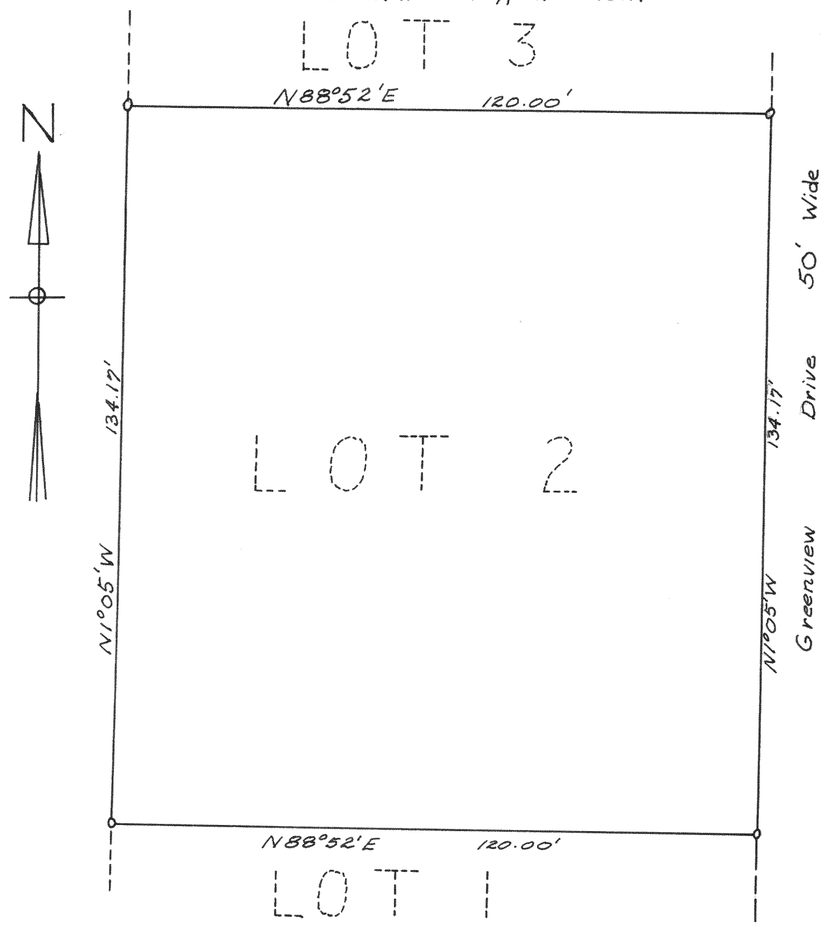


July 1962

Floyd L Jensen
Wal. Co. Surveyor

#4094

PLAT OF SURVEY OF
Lot 10, Edgewater Terrace
Located in Section, T1N, R17E
WALWORTH COUNTY, WISCONSIN

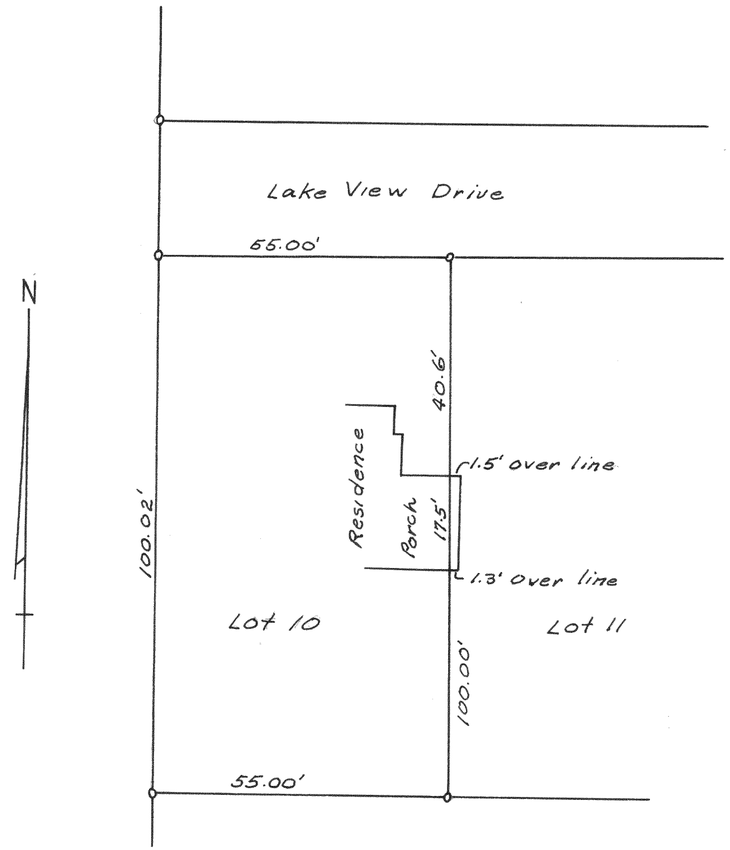

May 1959

Floyd L Jensen
Wal. County Surveyor