
4101

Plat of Survey of Lyons School as Fenced

A parcel of land located in the Northwest 1/4 of Sec. 10, T2N, R18E, Walworth County, Wisconsin and described as follows; Town: Commencing at the North 1/4 corner of said Sec. 10; Thence West 595.38 feet along the centerline of State Trunk Highway 36; Thence S 5°-48'W 33.85 feet to the corner post of a cyclone fence and the place of beginning; Thence continue S 5°-48'W 209.0 feet along said cyclone fence to a corner post; Thence N 79°-21' W 157.64 feet along the remains of a barbed-wire fence to the corner post; Thence N 75°25'W 127.9 feet to the corner post of a cyclone fence; Thence N 11°-35'E 142.8 feet along said cyclone fence to a corner post; Thence N 89°-39' E 270.7 feet along said cyclone fence to the place of beginning, intending to describe the land now enclosed by the fence for Lyons School

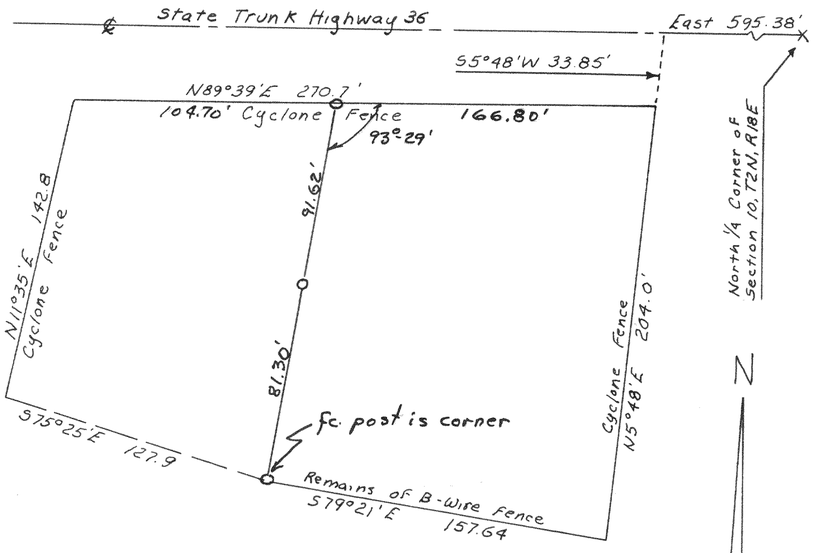


March, 1962

Floyd L Jensen
Wal Co. Surveyor

4102

Plat of Survey of

Lot 10 - Block 1, Miramar Subdivision located in Section 10 & 11 T.4N., R.18E. Walworth County, Wisconsin

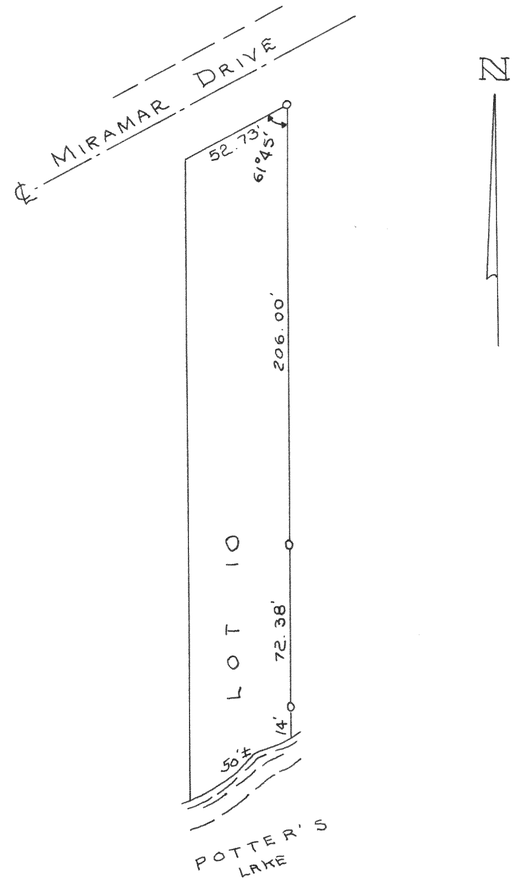

nov. 1962

Floyd L Jensen
Wal. Co. Surveyor