

2759

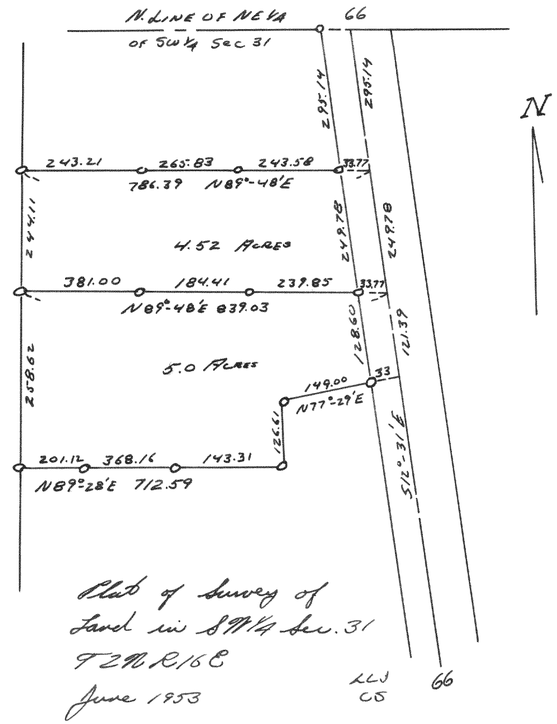

Plat of Survey of
Land in SW¼ Sec. 31
T2NR16E
June 1953

LLV
CS


2760

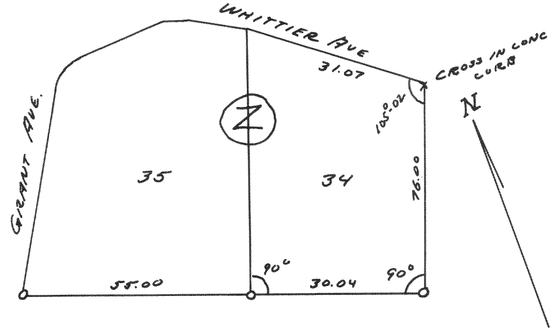

Plat of Survey of Lots 34 & 35
Block Z Assembly Grounds
T2NR16E
Oct, 1953

LLV
CS


2761

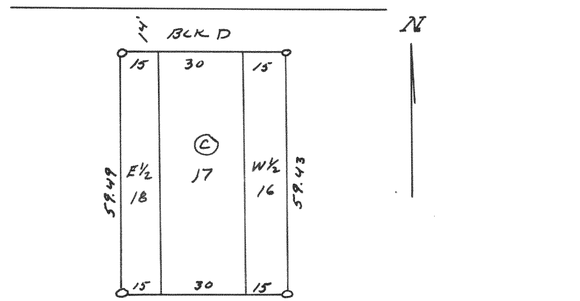

Plat of Survey of the West ½
of Lot 16, Lot 17 and the E ½
of Lot 18 Block C Jackson Sub.
T2NR16E
Oct 1953

LLV
CS


2762

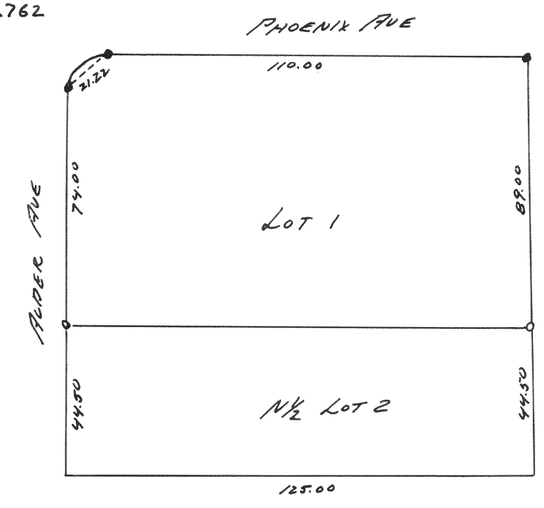

Plat of Survey of Lot 1 & N½ Lot 2
Blk 2 Allynhurst Sub.
Sec. 17 & 20 T2NR16E
Sept 1953

LLV
CS

2763

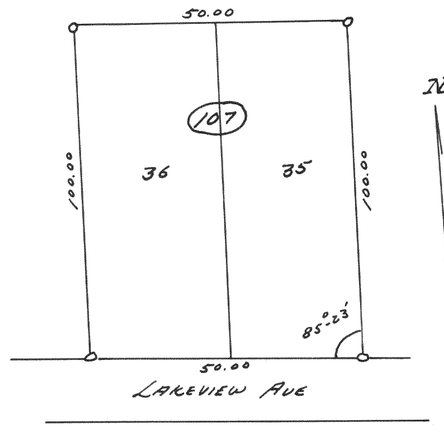

Plat of Survey of
Lots 35 & 36 Block 107
Lake Manawaya Sub
T3NR16E
May 1953

LLV
CS