
#4108


Plat of Survey of
Part of Lot 5 of Observatory Subdivision
Located in the Village of Williams Bay,
In Walworth County, Wisconsin

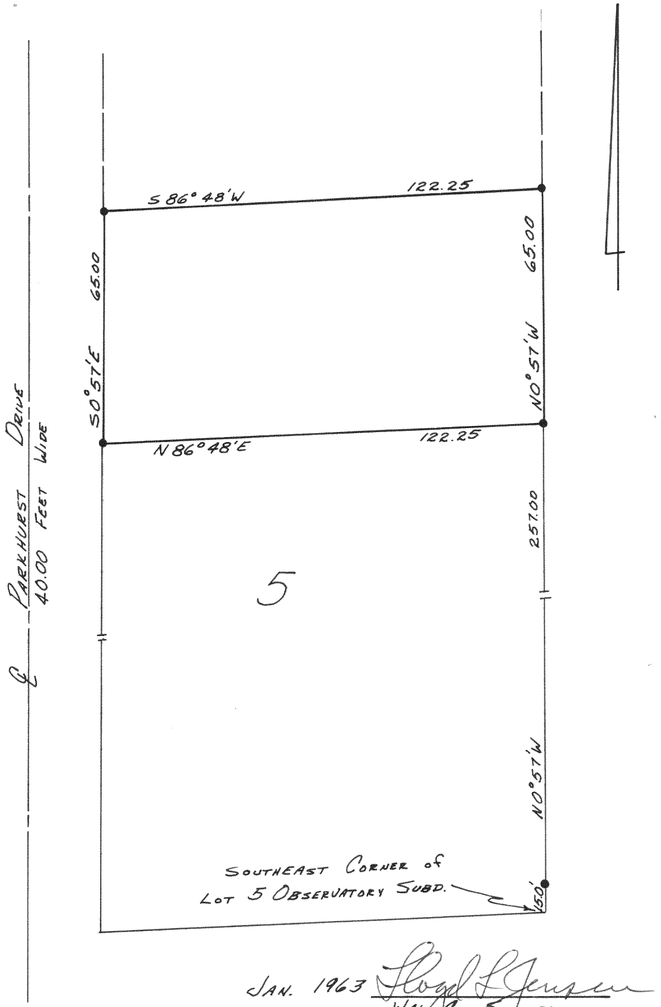

JAN. 1963 Floyd L. Jensen
WAL. CO. SURVEYOR

#4109

Plat of Survey of
SW ¼ of NW ¼ of Sec. 5, T 4N, R 15E,
City of Whitewater, Walworth County, Wisc.

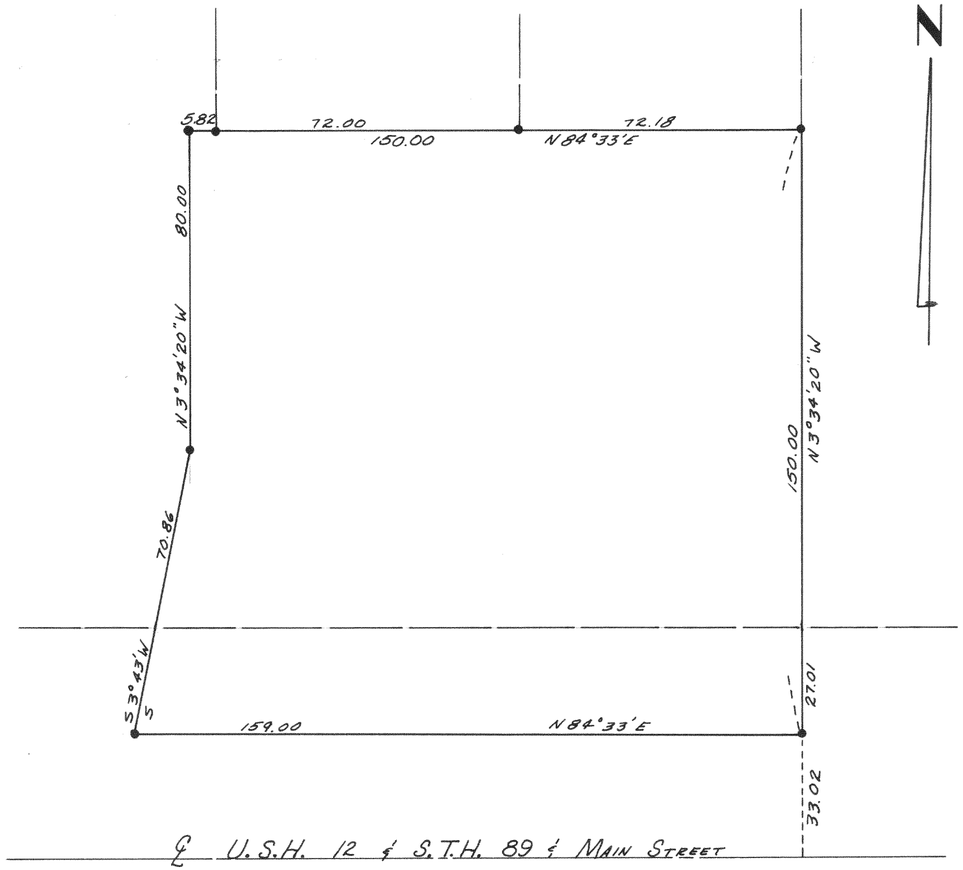

DEC. 1962 Floyd L. Jensen
WAL. CO. SURVEYOR