
364

PLAT of SURVEY of LOT 3 of THE BIRCHES, A SUBDIVISION LOCATED IN SEC. 10, T 1N, R 17E of WALWORTH COUNTY, WISCONSIN


#4114

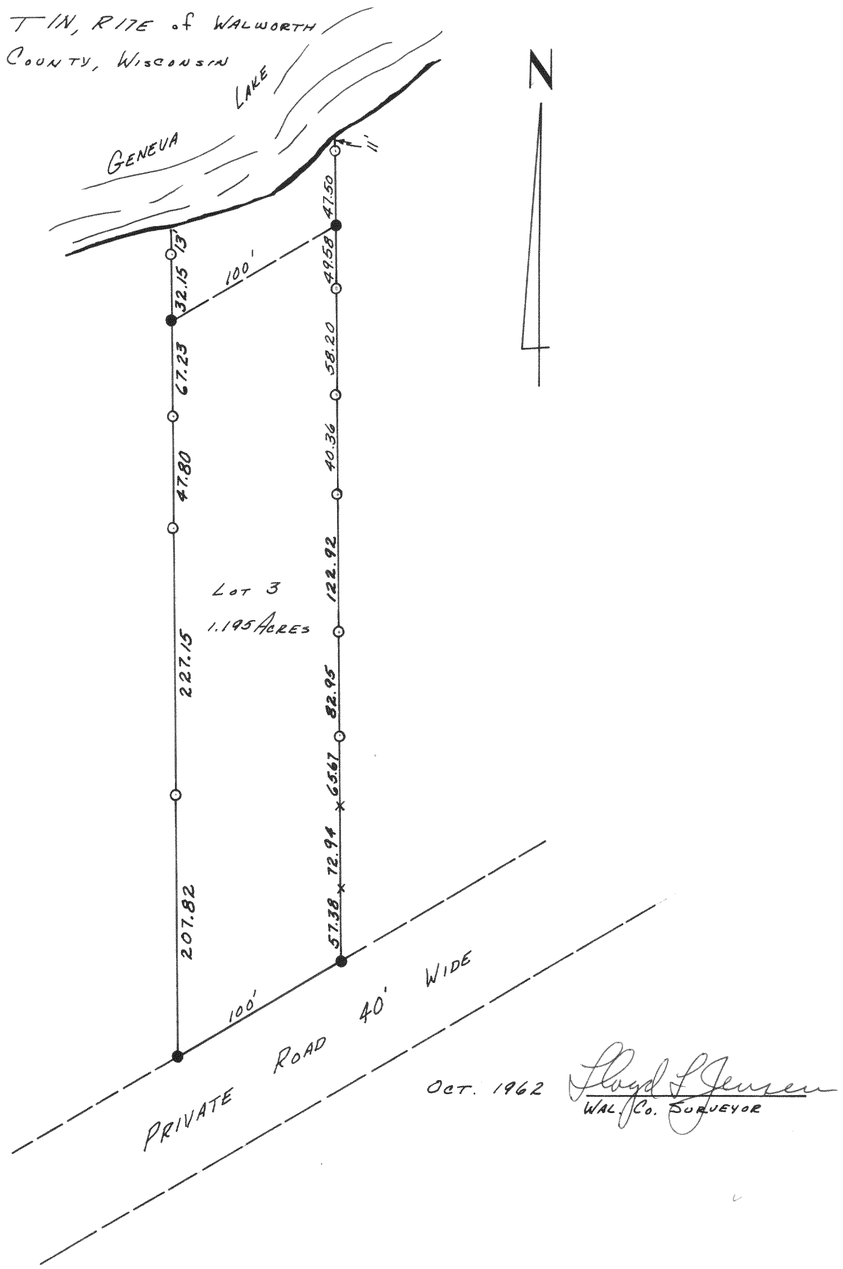

OCT. 1962 Floyd L Jensen
WAL. Co. SURVEYOR

#4115

PLAT of SURVEY of A PARCEL of LAND LOCATED PARTLY IN SEC. 4-T4N-R18E & PARTLY IN SEC. 5-T4N-R18E, WALWORTH COUNTY, WISCONSIN

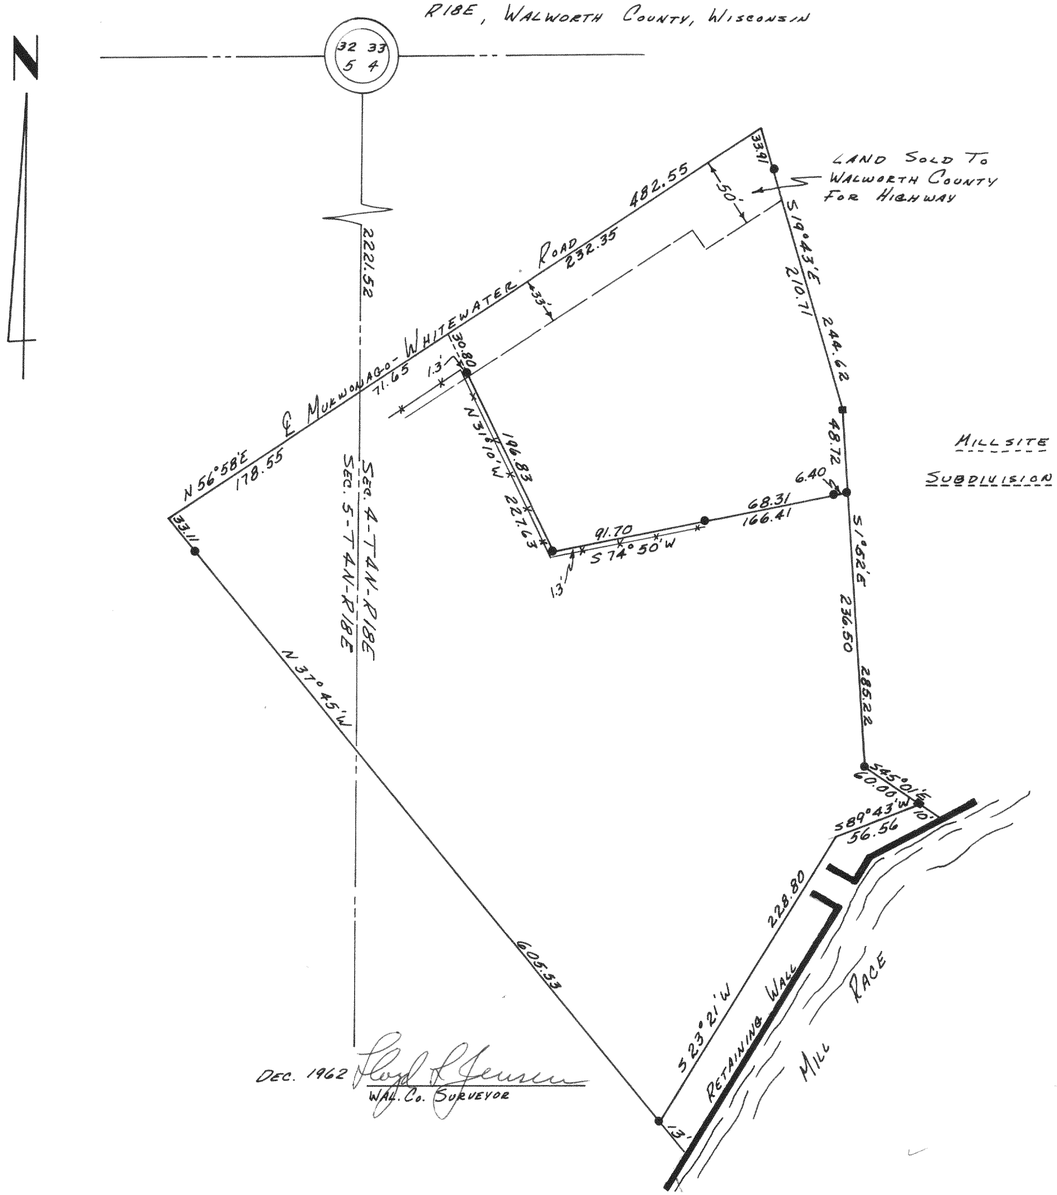

DEC. 1962 Floyd L Jensen
WAL. Co. SURVEYOR