
#4124


PLAT OF SURVEY OF
LAND LOCATED IN THE NW¼ OF
SECTION 29, T3N R18E OF WALWORTH
COUNTY, WISCONSIN

JULY 1962 Floyd L. Jensen
WAL. CO. SURVEYOR

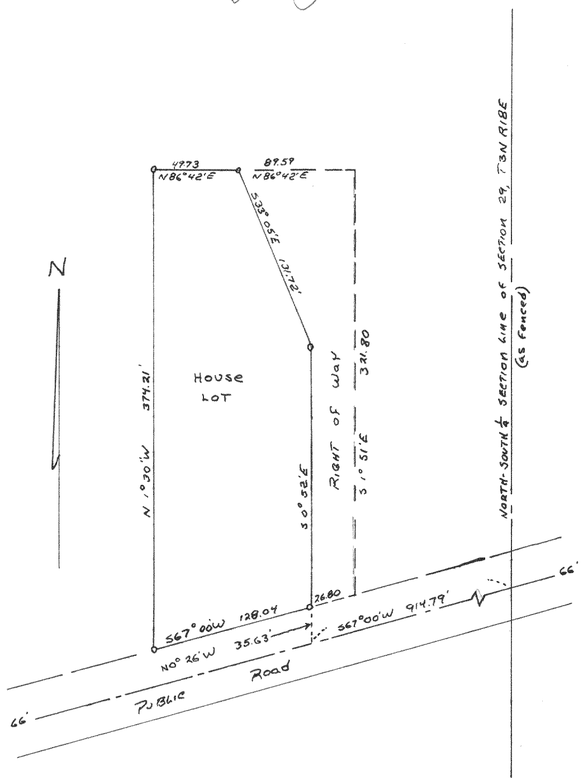

#4125

PLAT OF SURVEY OF
PAUL REMER FARM located in THE
N½ OF THE NE¼ of Section 18-2-17

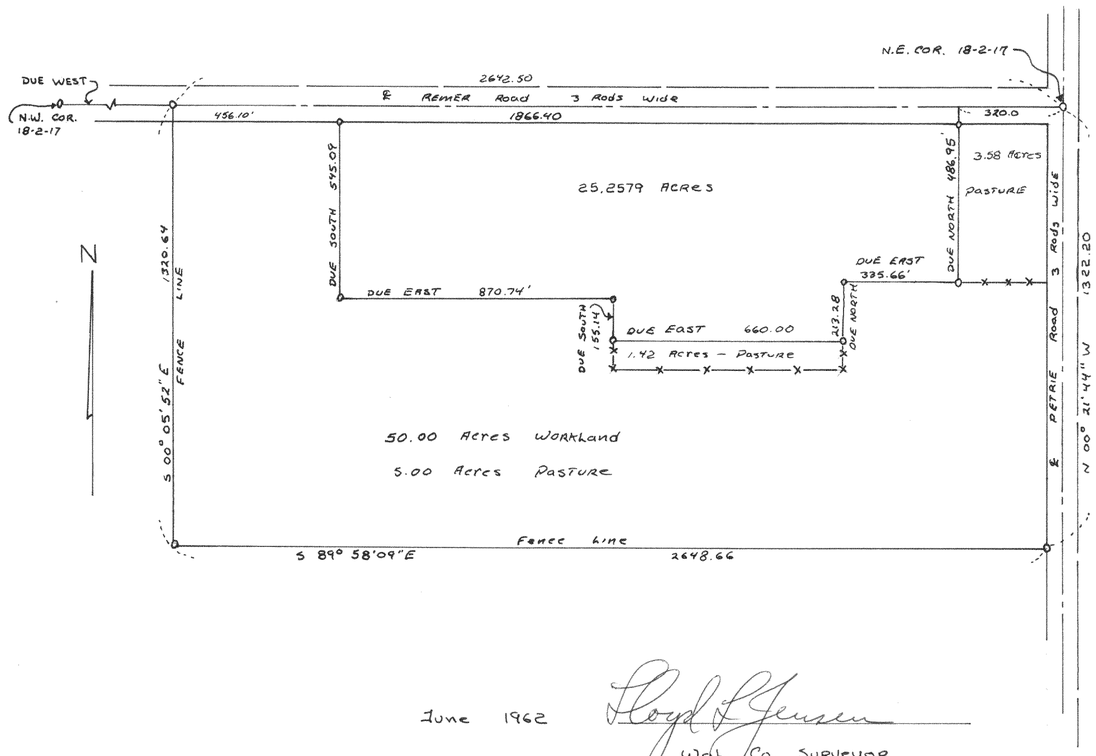

June 1962 Floyd L. Jensen
Wal. Co. SURVEYOR