
#4130

PLAT OF SURVEY OF
Lot 1, Block W, Delavan Lake
Assembly Park, Section 21, T2N,
R16E, Walworth County, Wisconsin.

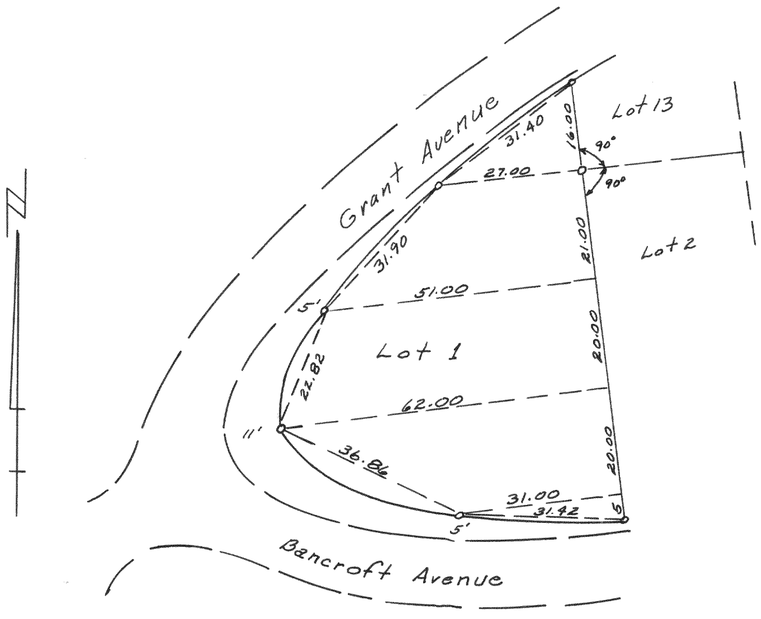


November 24, 1962

Floyd L Jensen
County Surveyor

#4131

PLAT OF SURVEY OF
Lot 6 and the West 45 feet of lot 7
of Cedar Point Subdivision
located in section 28, T2N, R16E,
Walworth County, Wisconsin.

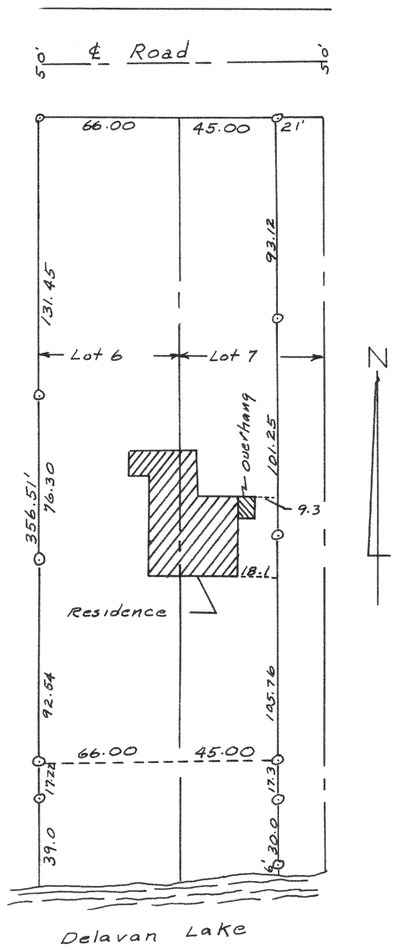

August 4, 1962

Floyd L Jensen
County Surveyor