

#4134

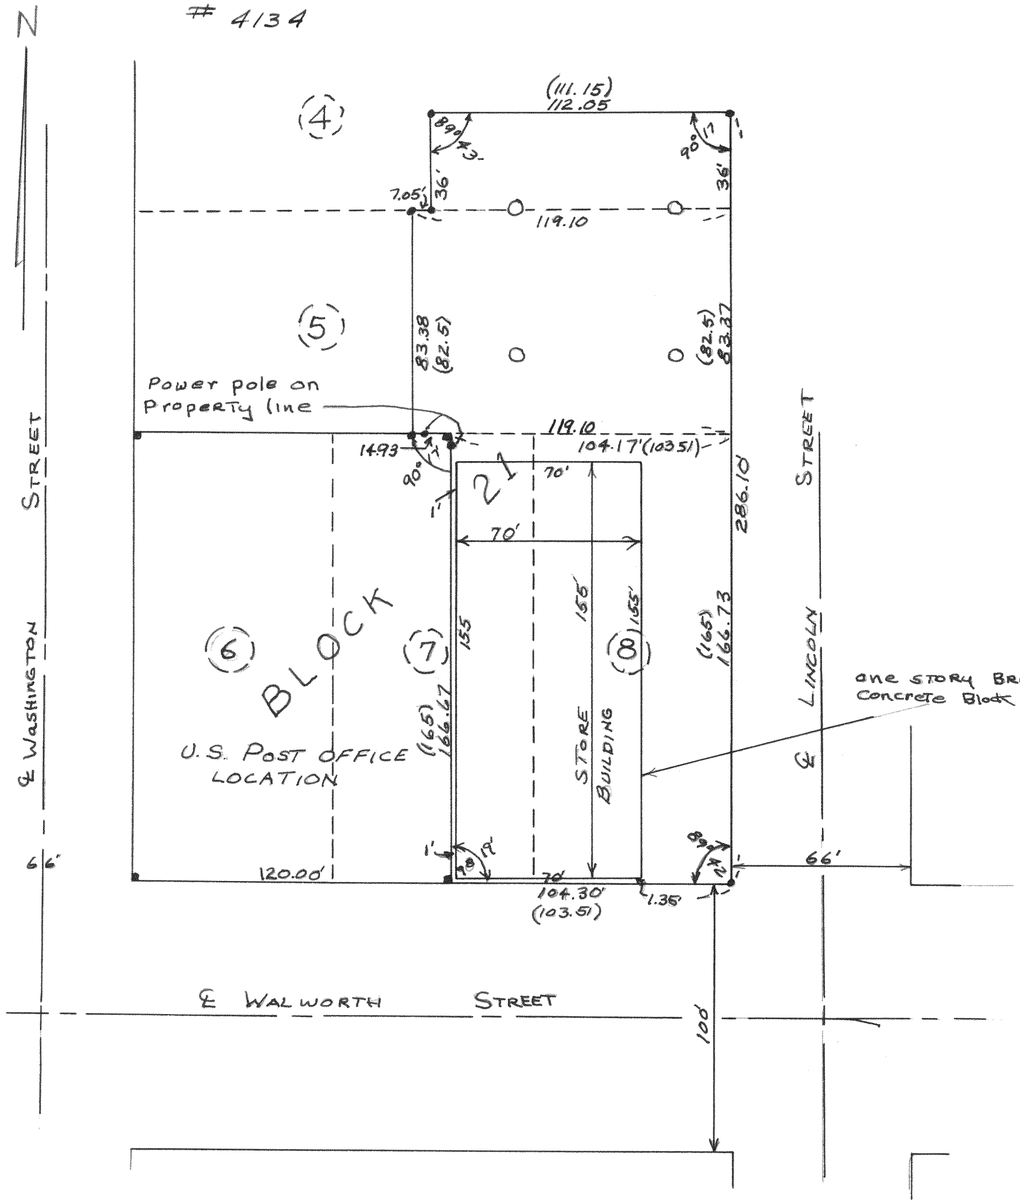

Plat of Survey located in the City of Elkhorn, Walworth County Wisconsin

July 1963 Floyd L Jensen
Walworth County Surveyor

#4135

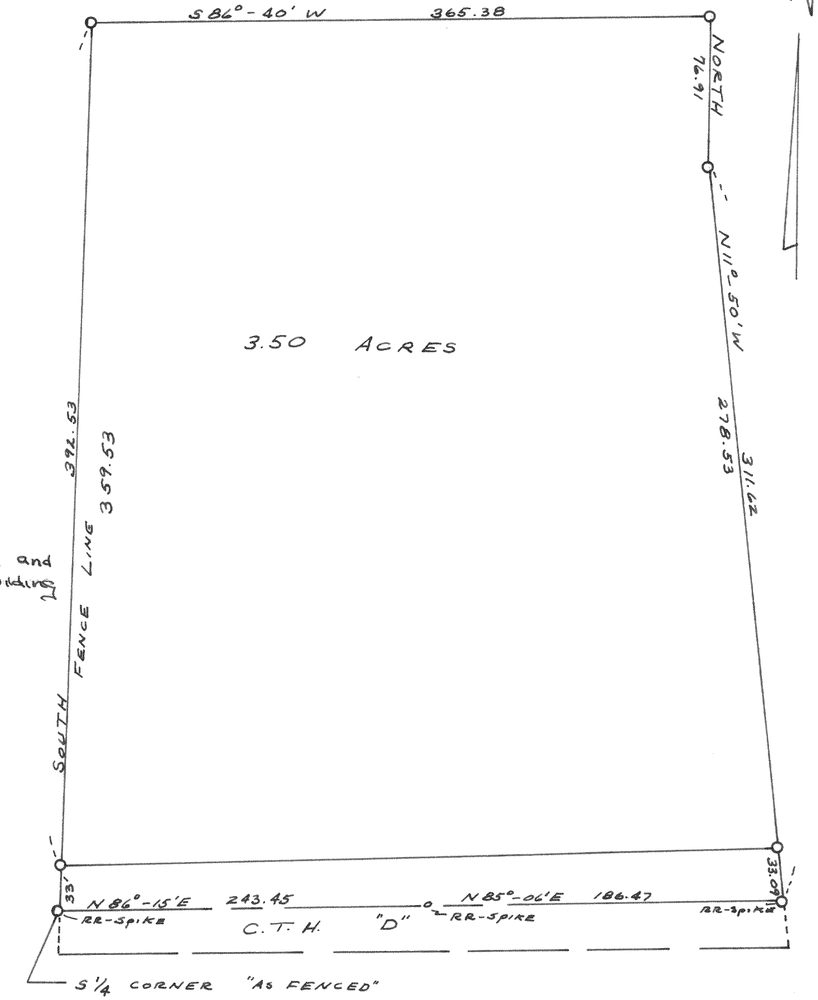

PLAT OF SURVEY OF LAND LOCATED IN THE SE 1/4 OF SECTION 2, T3N, R17E, WALWORTH COUNTY, WISCONSIN.

NOV. 1963 Floyd L Jensen
COUNTY SURVEYOR