
382


#4140

Plat of Survey of part of lots 4-5-6, Block 5, First Addition to lake Elizabeth Manor, Village of Twin lakes, Kenosha County, Wisconsin

August 1963 Floyd L Jensen
Walworth County Surveyor

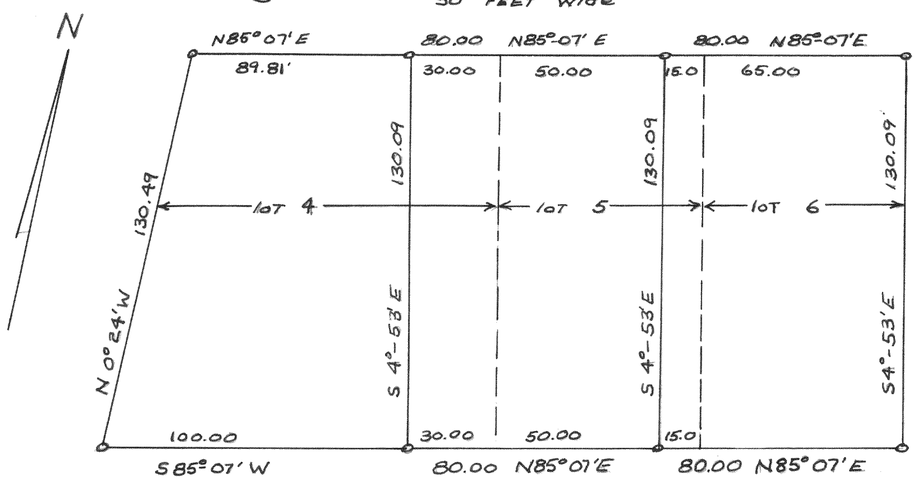

#4141

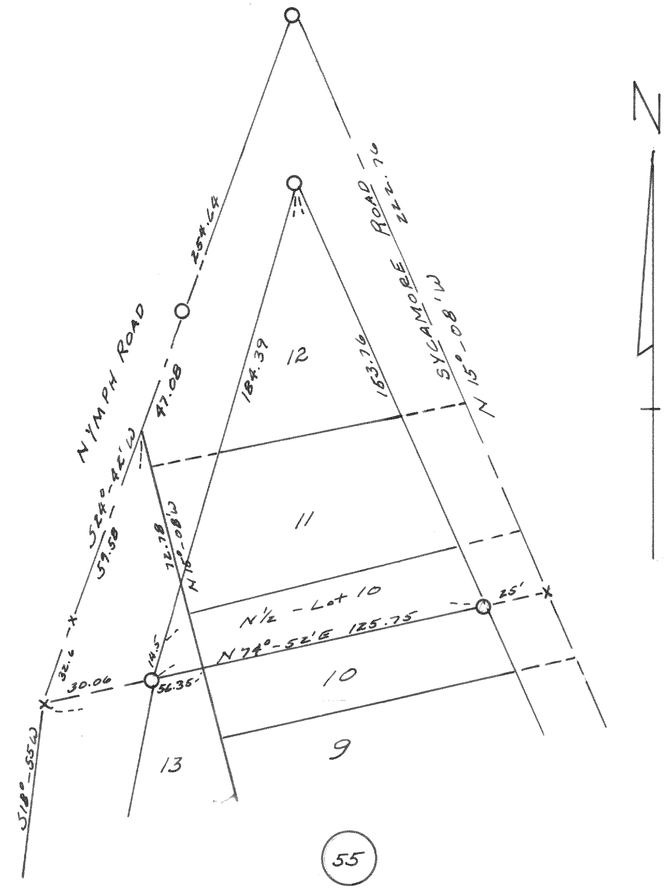

Plat of Survey of the N½ Lot 10, Lot 11, Lot 12 Part of Lot 13 Block 55, 4th Map Interlaken, Section 11, T3N, R16E Walworth County, Wisconsin

Dec. 1963 Floyd L Jensen
Walworth County Surveyor