
384

PLAT OF SURVEY OF #4144

LOTS 230, 231 & 232 OF THE 3RD ADDITION TO CEDAR POINT PARK OF WM BAY, WISCONSIN

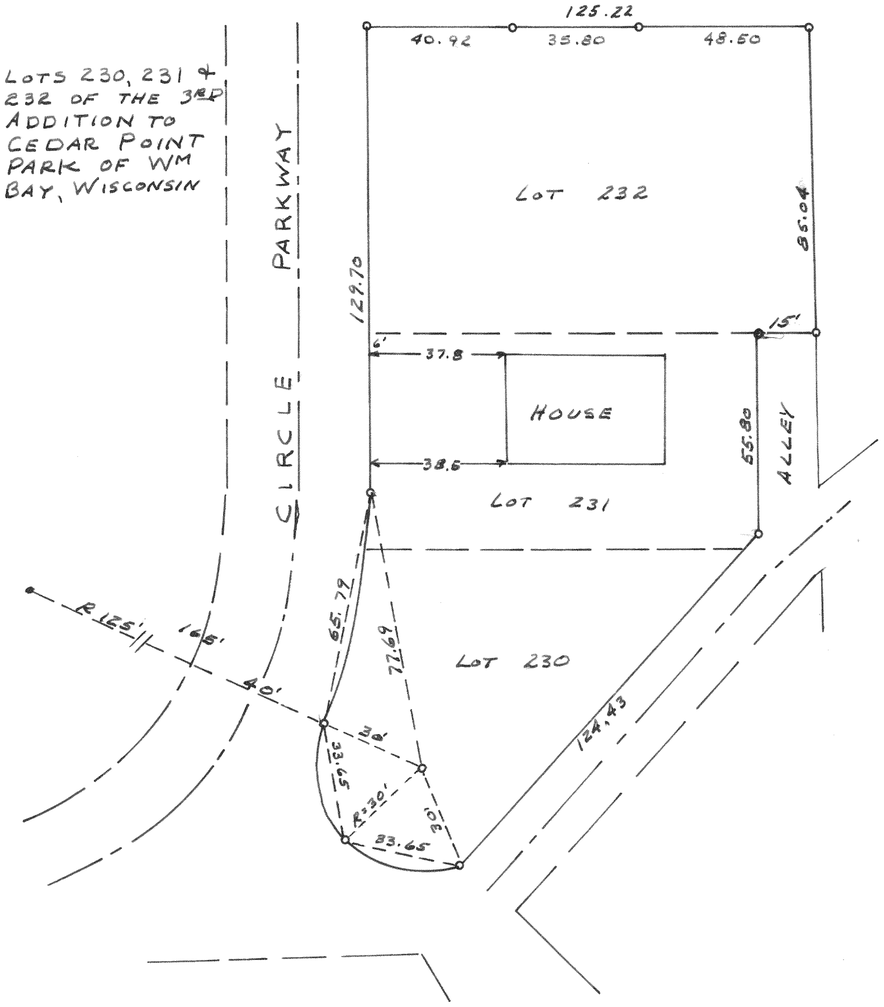

SEPT. 1963

Floyd L Jensen
COUNTY SURVEYOR

PLAT OF SURVEY

#4145 OF

LOT 32 OF LYNNDALE SUBDIVISION LOCATED IN THE SE¼-NW¼ AND THE SW¼ NW¼ OF SECTION 20, T4N, R18E VILLAGE OF EAST TROY, WALWORTH COUNTY, WISCONSIN

JULY 13, 1963

Floyd L Jensen
COUNTY SURVEYOR

