

#4154

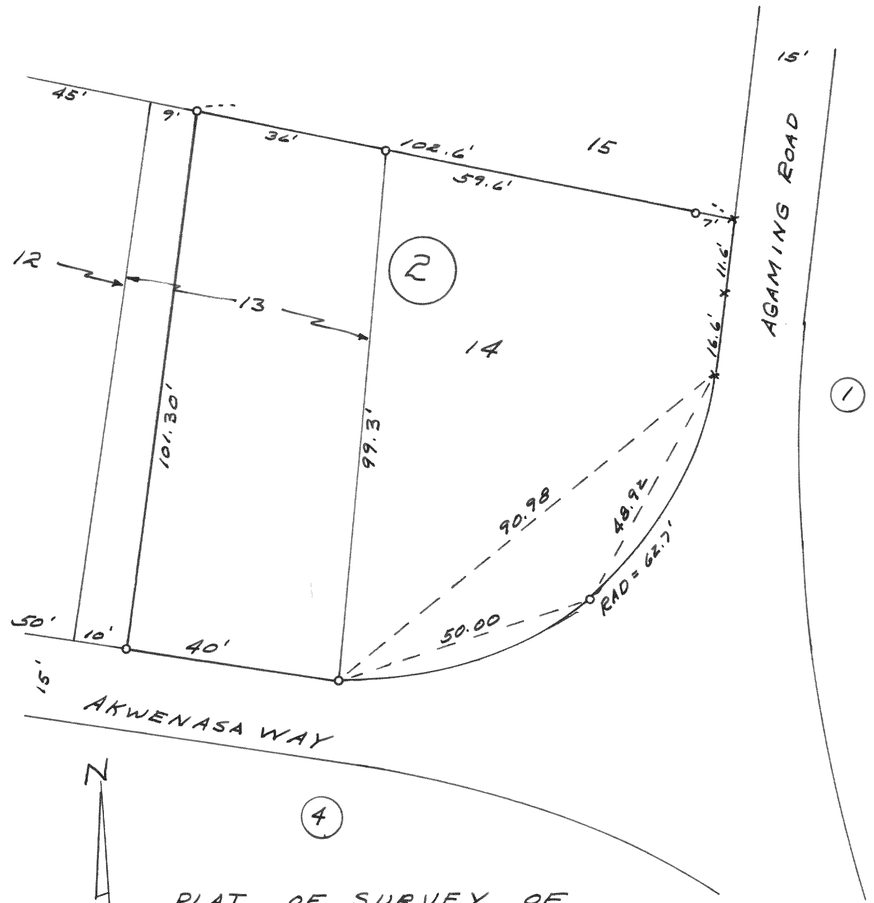

PLAT OF SURVEY OF PART OF LOT 13 & LOT 14, BLOCK 2, INDIAN HILLS SUBDIVISION, VILLAGE OF FONTANA-ON-GENEVA LAKE, WALWORTH COUNTY, WISCONSIN.

MAY 1963 Floyd L Jensen COUNTY SURVEYOR

#4155

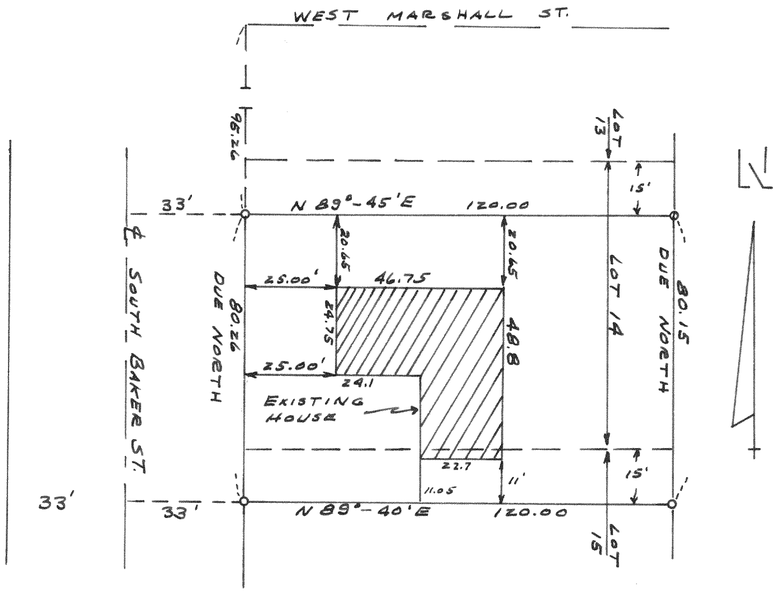

PLAT OF SURVEY

OF LOT 14 OF BLOCK 3 EXCEPT THE NORTH 15 FEET OF LOT 15 OF BLOCK 3 OF JAMES JONES 2ND. ADDITION, A SUBDIVISION LOCATED IN THE NE¼ AND THE NW¼ OF SECTION 1, T2N, R16E, CITY OF ELKHORN, WALWORTH COUNTY, WISCONSIN.

NOV. 24, 1963 Floyd L Jensen COUNTY SURVEYOR