
2773

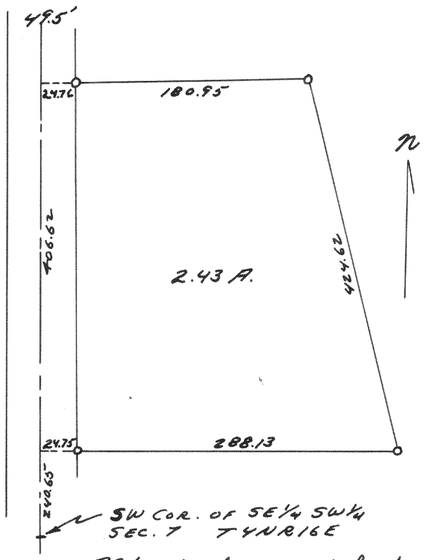


Plat of Survey of Land Located in the SE¼ SW¼ Section 7 T4NR16E

July, 1953

LLJ CS

2774

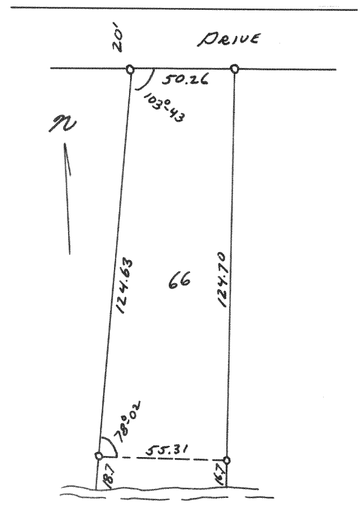


Plat of Survey of Lot 66 of Sandsdale Heights Sub

T4NR16E

Aug. 1953

LLJ CS

2775

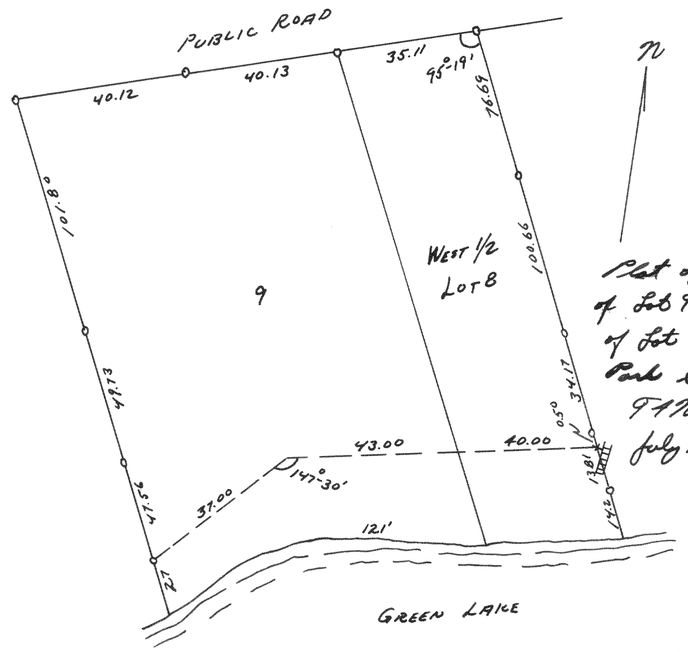


Plat of Survey of Lots 9 & West ½ of Lot 8 Morris Park Subdivision

T4NR16E

July 1953

LLJ CJ

2776

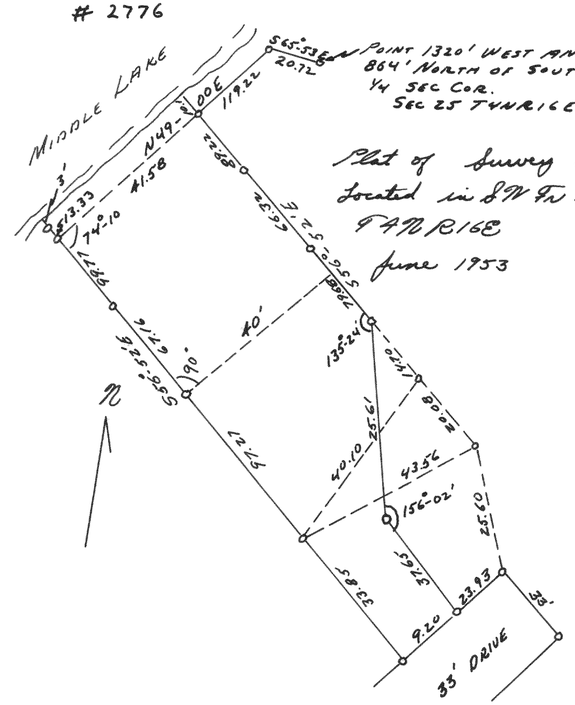


Plat of Survey of Land Located in SW¼ SW¼ Sec. 25 T4NR16E

June 1953

LLJ CS

2777

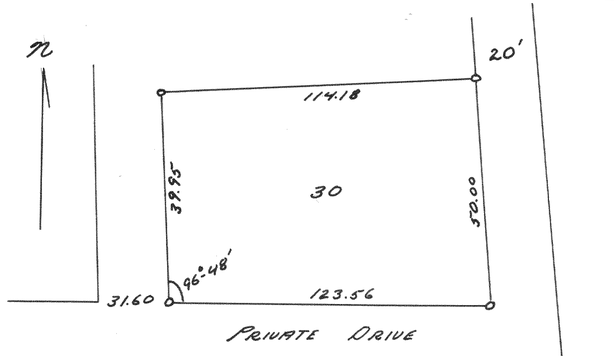


Plat of Survey of Lot 30 Lost Nation Park

T4NR16E

Sept 1953

LLJ CS

2778

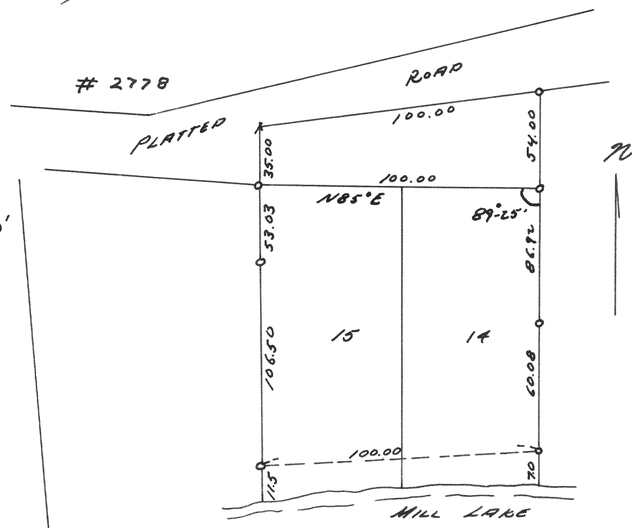

Plat of Survey of Lots 14 & 15 Block 3 Caswell Park and adjoining parcel

T4NR16E

June 1953

LLJ CS