
#4158

PLAT OF SURVEY OF

ALL THAT PART OF LOTS 1, 5, 8, 9 OF BLK 2 OF THE ORIGINAL PLAT TO THE CITY OF LAKE GENEVA, WALWORTH COUNTY, WISCONSIN.

BEG. AT THE NE COR. OF said Lot 4 + running thence S along the E line of said BLK 2, 200.00'; thence W at right angles to E line of said BLK 2, 134.00'; thence N parallel to the E line of said BLK 2, 124.00'; thence E parallel to the N line of Said Lot 4, 34.00' thence N parallel to the E line of said BLK 2, 75.00'; thence E along the N line of said Lot 4, 100.00' to the point of beginning.

MAY 16, 1963 — Floyd L Jensen, COUNTY SURVEYOR

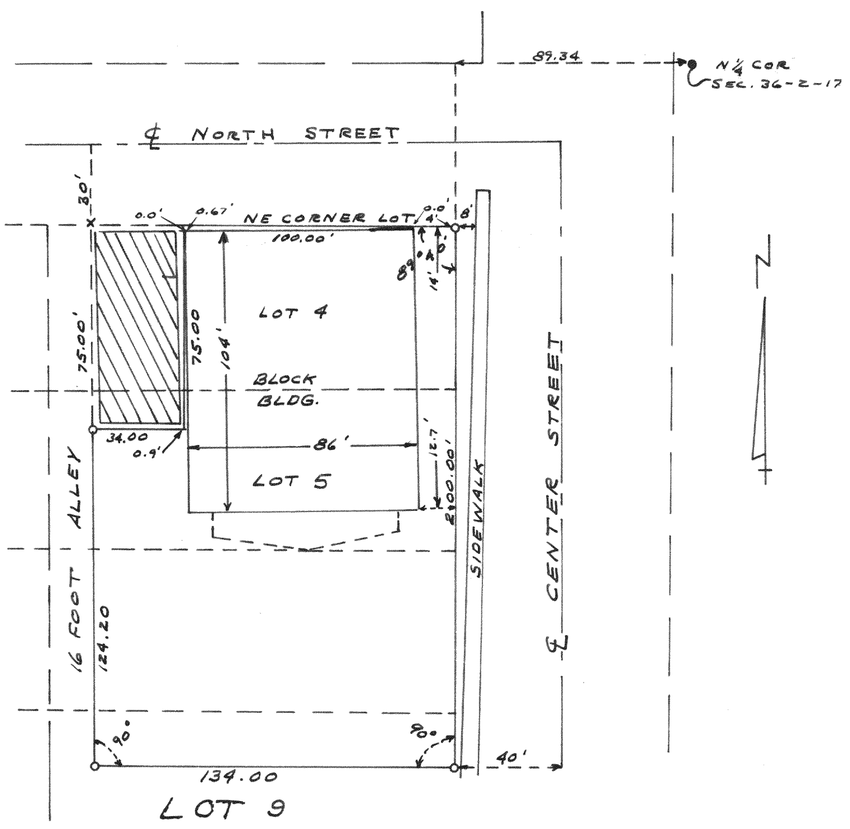

#4159

PLAT OF SURVEY OF

LOT 14 OF Block 3 except the North 15 Feet, and the North 15 feet of Lot 15 of Block 3, of James Jones Addition, a subdivision located in the NE¼ and the NW¼ of Section 1, T2N, R16E, City of Elkhorn, Walworth County, Wisconsin.

JUNE 10, 1963 — Floyd L Jensen, COUNTY SURVEYOR

