

#4160

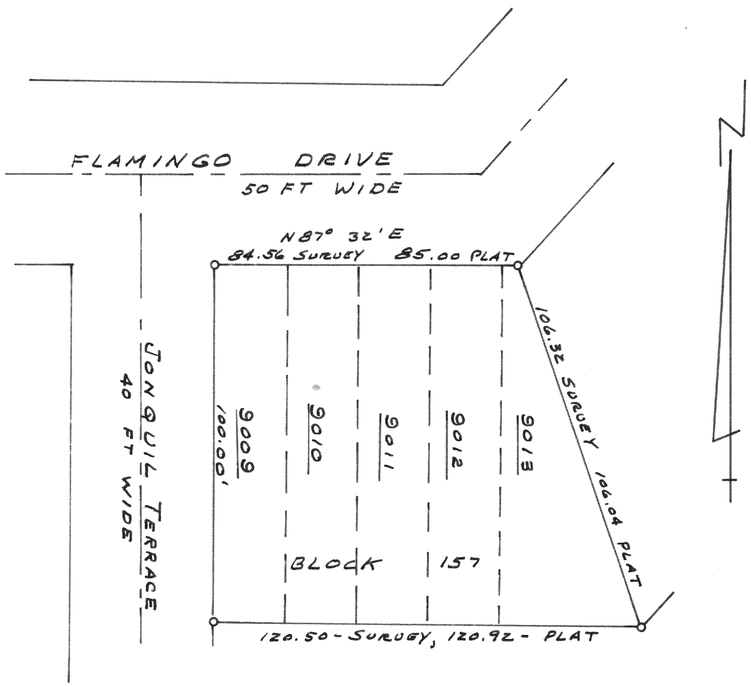

PLAT OF SURVEY OF
LOTS 9009, 9010, 9011, 9012, 9013 BLOCK 157,
LOCATED IN SECTION FIVE OF PELL LAKE
SUBDIVISION IN SECTION 22, T1N, R18E,
WALWORTH COUNTY, WISCONSIN.

JUNE 29, 1963 Floyd L Jensen
COUNTY SURVEYOR

#4161

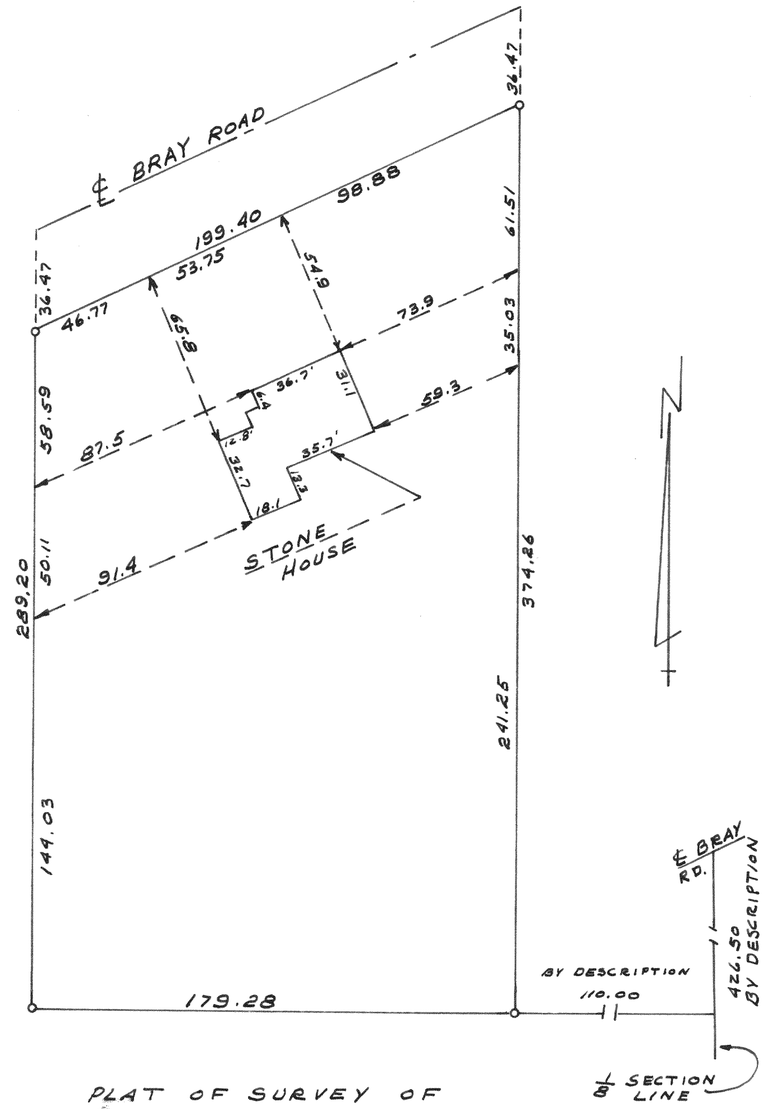

PLAT OF SURVEY OF
LAND LOCATED IN THE SW 1/4 - SW 1/4
SECTION 26, T3N, R17E, WALWORTH
COUNTY, WISCONSIN.

OCT. 28, 1963 Floyd L Jensen
COUNTY SURVEYOR