
402

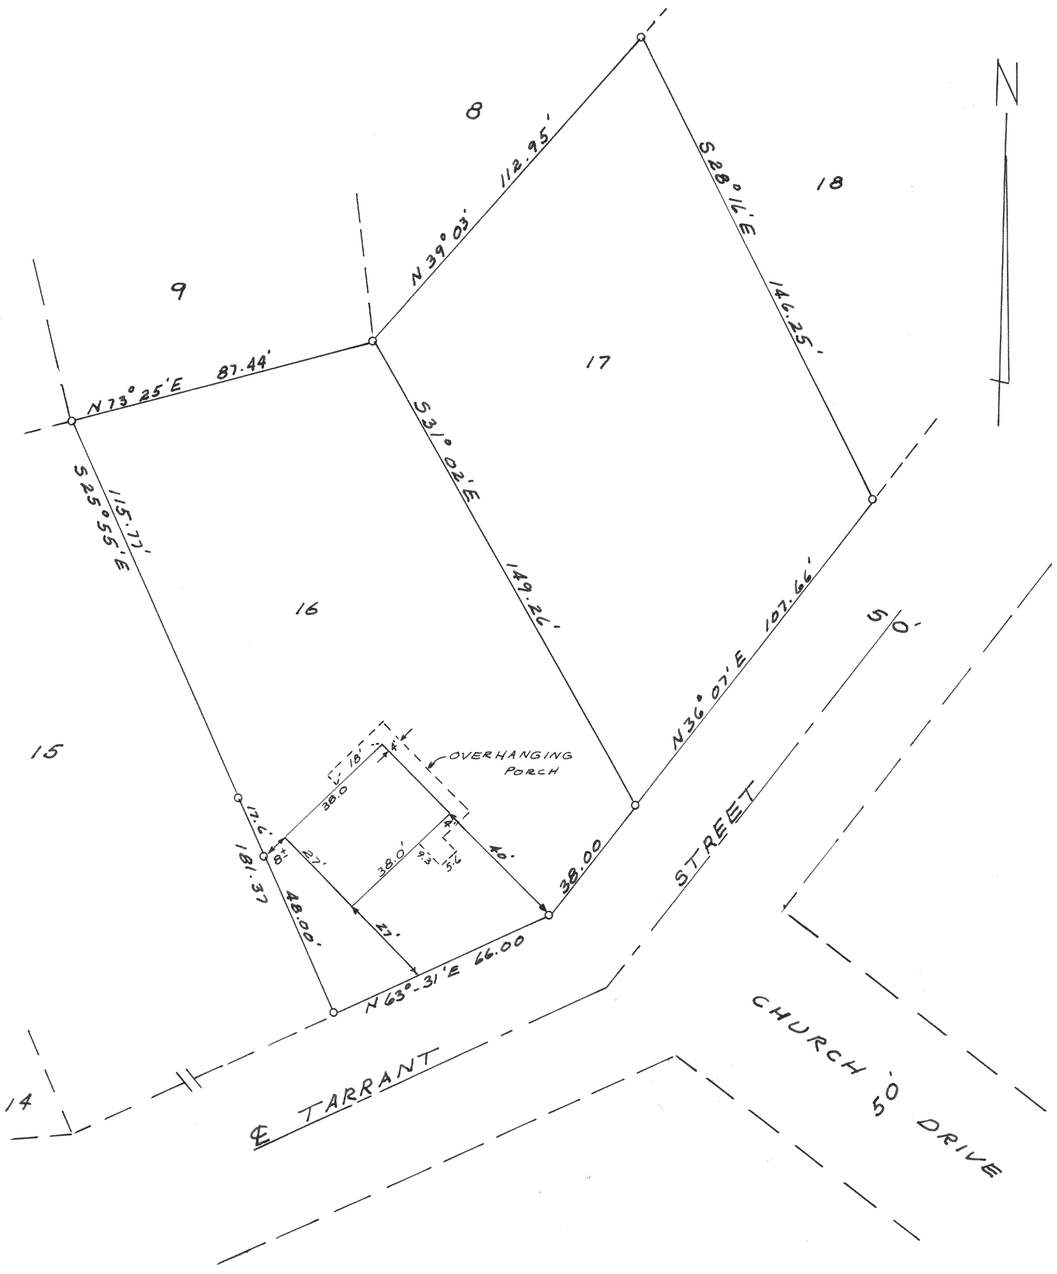

#4171

PLAT OF SURVEY OF
Lots 16 & 17 of Addition No. 1
To Country Club Estates,
Fontana-on-Geneva Lake,
Walworth County, Wisconsin.

JUNE 4, 1963

Floyd L. Jensen
COUNTY SURVEYOR