PLAT OF SURVEY OF
Town Park, 20' Right of Way to Lake between block 1 & 2, and the open block Southwest of the Town Park - Located in "WILMER GROVE BEACH"
E½ Sec. 18, T4N, R18E, Walworth County, Wisconsin

#4172

Floyd Gunsen
County Surveyor

August 31, 1963

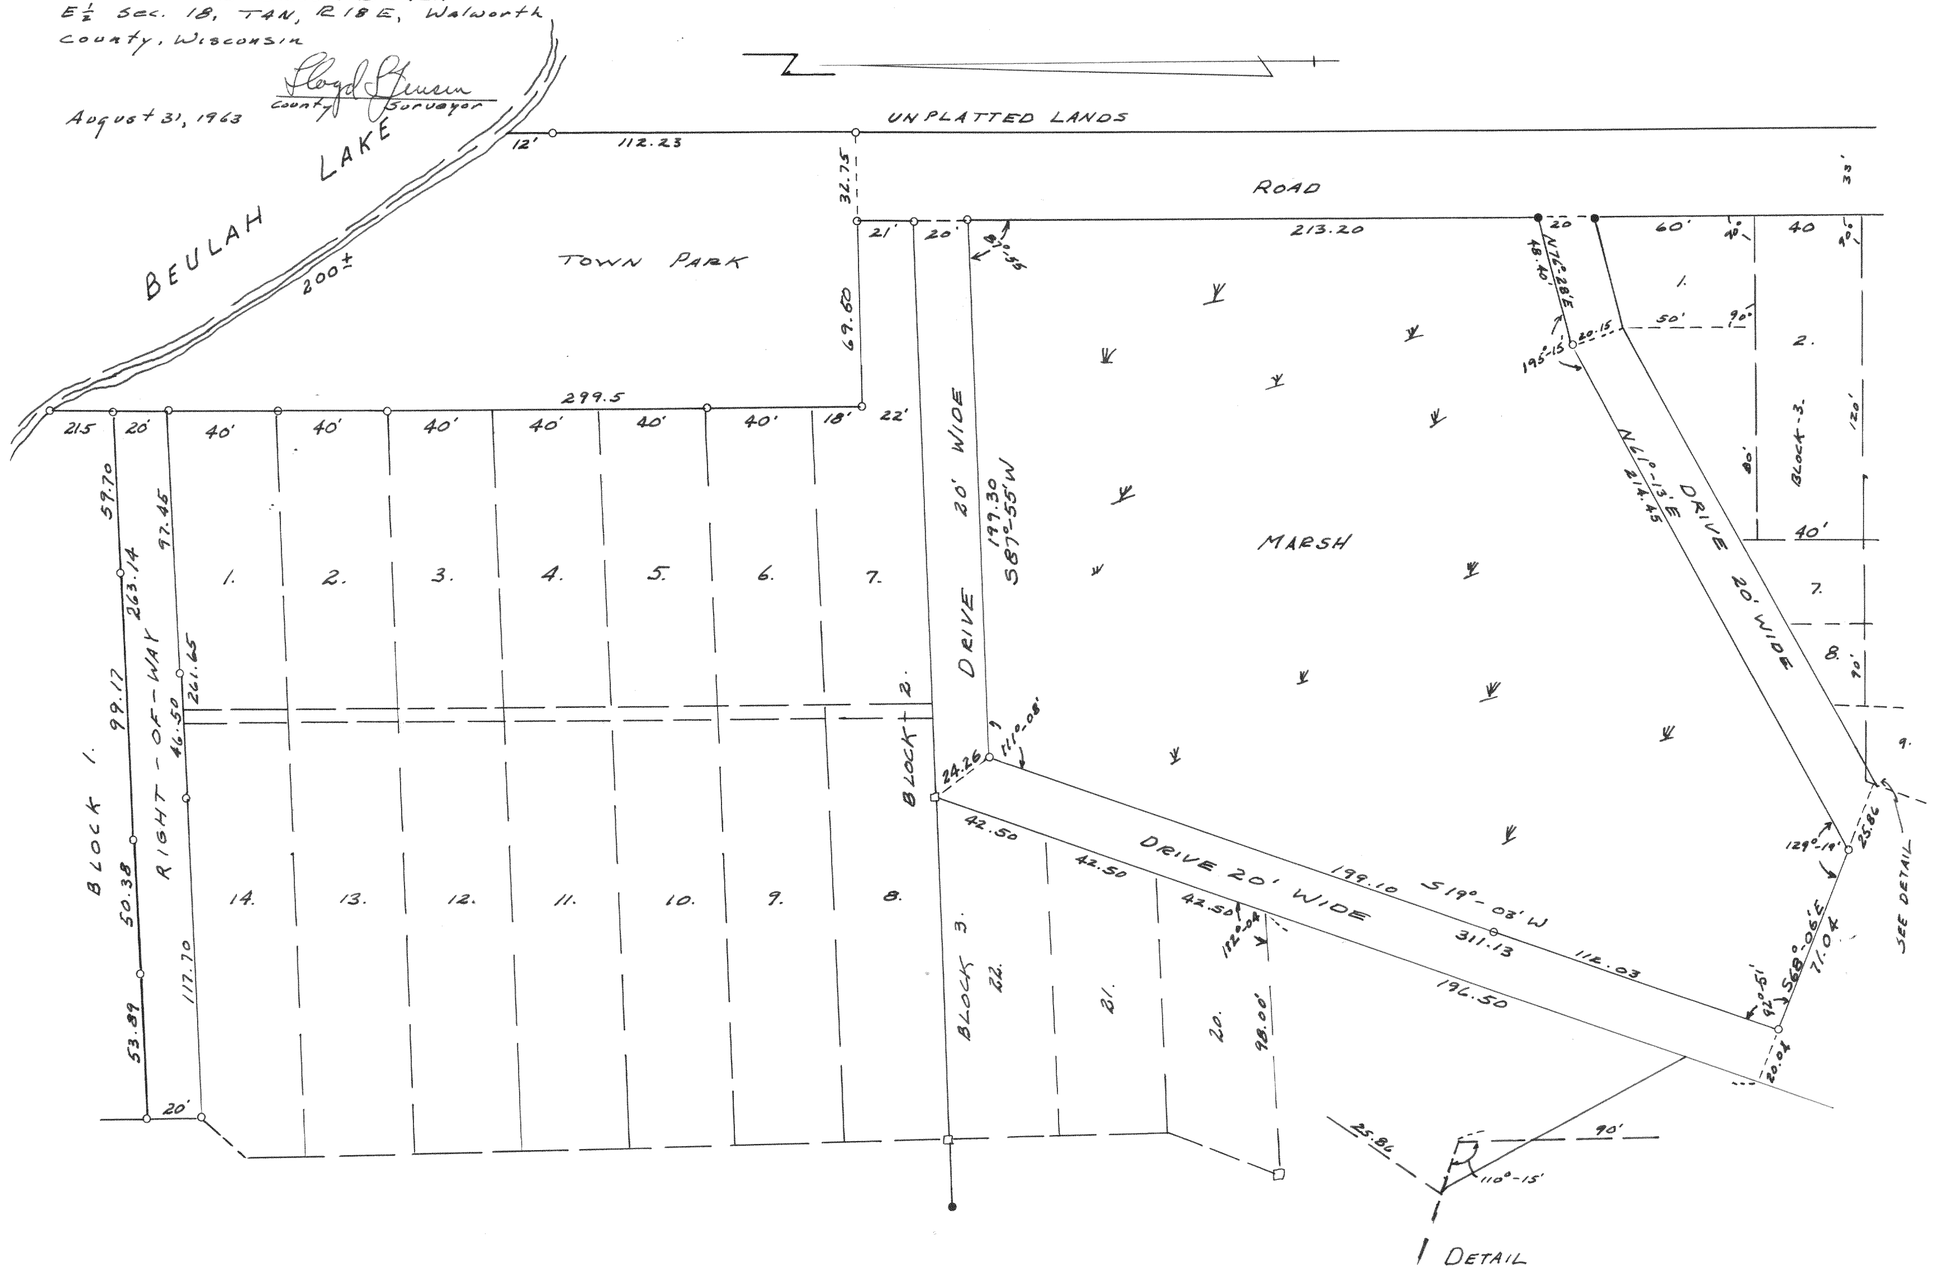
UNPLATTED LANDS
ROAD
BEULAH LAKE
200±
TOWN PARK
MARSH
BLOCK 1.
BLOCK 2.
BLOCK 3.
RIGHT - OF - WAY
DRIVE 20' WIDE
DRIVE 20' WIDE
DRIVE 20' WIDE
SEE DETAIL
DETAIL
299.5
112.23
32.75
69.60
213.20
197.30
S87°-55'W
N76°-28'E
48.40
N61°-13'E
214.45
199.10
S19°-03'W
311.13
112.03
196.50
42.50
42.50
42.50
24.26
25.86
71.04
S68°-06'E
110°-15'
129°-19'
195°-15'
112°-04'
111°-08'
92°-51'
90°
90°
90°